

INFORMATION HANDOUT

For Contract No. 11-406904

At 11-SD-8-R25.9/R32.2

Identified by

Project ID 1100020391

MATERIALS INFORMATION

Water Source Information

- Padre Dam Municipal Water District, dated 6/30/2014

From: Dan Black [<mailto:dblack@padre.org>]
Sent: Monday, June 30, 2014 10:49 AM
To: Aguilar, Oscar M@DOT
Cc: Cheryl Brugman; Courtney Mael
Subject: Construction Water Availability

Padre Dam MWD will have potable water available for the Caltrans Pavement Rehabilitation Project in the Alpine area shown on the attached drawing. However, the Padre Dam and San Diego County Water Authority (SDCWA) boundary ends just west of the West Willows Road over pass, marked in red on the attachment. Water is neither available nor can any be transported past this boundary per our legal restrictions with the SDCWA. Should a Caltrans contractor be caught taking water out of our area, all construction meters will be removed for a minimum of one week.

Padre Dam does produced recycled water that is available in the Santee area. It may be purchased and transported anywhere in the County.

Dan

Daniel J. Black, P.E.
Engineering Manager – Development/Construction
Padre Dam Municipal Water District
T 619.596.3146
C 619.602.1805
F 619.449.8629

INDEX OF PLANS

STATE OF CALIFORNIA
 DEPARTMENT OF TRANSPORTATION
 STATE PLANS FOR CONSTRUCTION ON
 PROJECT PLANS FOR CONSTRUCTION ON
 STATE HIGHWAY



IN SAN DIEGO COUNTY NEAR ALPINE FROM
 0.2 MILE EAST OF HARBISON CANYON ROAD
 UNDERCROSSING TO 0.4 MILE
 EAST OF VIEJAS CREEK BRIDGE

TO BE SUPPLEMENTED BY STANDARD PLANS DATED 2010

Begin Work
 Sta "SD-8" 1442+75

BEGIN CONSTRUCTION
 Sta "SD-8" 1502+65
 PM R25.9

*No PROBE DAM
 WHEN PAST THIS
 LINE.*

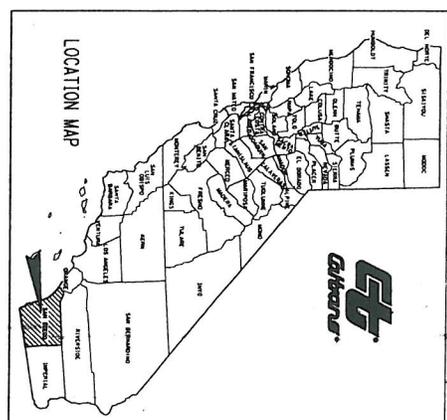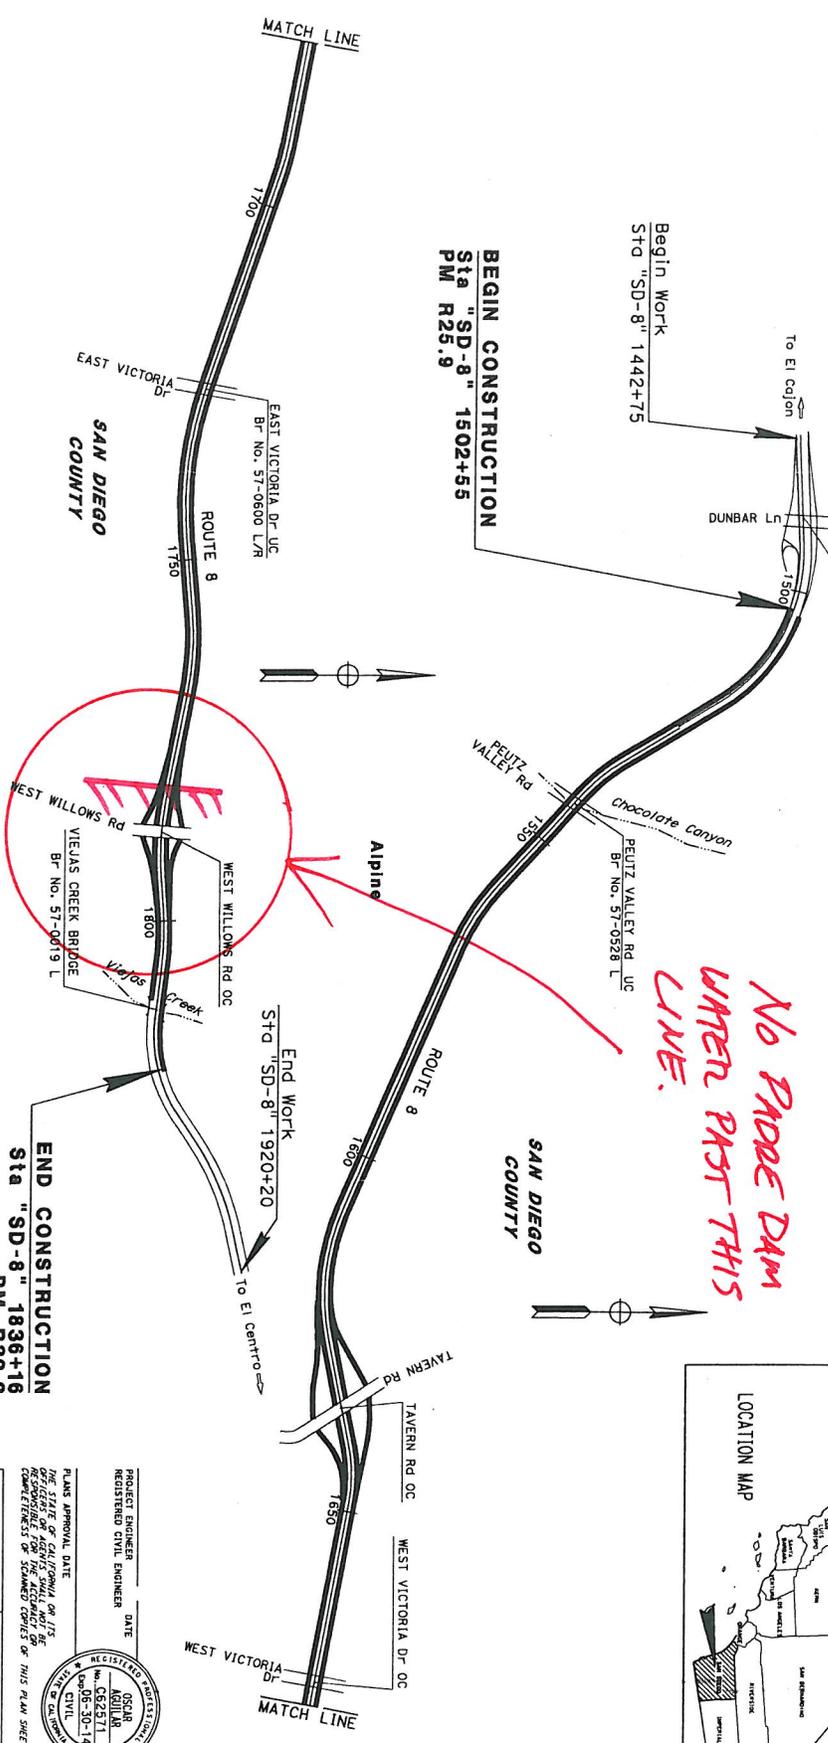

DIST	COUNTY	ROUTE	POST MILE TOTAL PROJECT	SHEET NO.	TOTAL SHEETS
11	SD	8	R25.9/R32.2	1	1

DESIGN ENGINEER	PROJECT MANAGER
OSCAR M AGUILAR	BRUCE LAMBERT

THE CONTRACTOR SHALL POSSESS THE CLASS (OR CLASSES) OF LICENSE AS SPECIFIED IN THE NOTICE TO BIDDERS.

BORDER LAST REVISED 7/2/2010

CALTRANS WEB SITE IS: HTTP://WWW.DOT.CA.GOV/

RELATIVE BORDER SCALE 0 1 2 3
 1/8 IN INCHES

USENAME => 4129319
 DGN FILE => 1100020391.dgn

UNIT 2761

CONTRACT NO. 11-408904
 PROJECT ID 1100020391
 PROJECT NUMBER & PHASE 11000203911

PLANS APPROVAL DATE

REGISTERED PROFESSIONAL ENGINEER

OSCAR M AGUILAR
 No. C62571
 Exp. 05-30-14
 CIVIL

PROJECT ENGINEER DATE

REGISTERED CIVIL ENGINEER

THE STATE OF CALIFORNIA, ON ITS BEHALF, I HEREBY CERTIFY THAT THE ABOVE ENGINEER IS A LICENSED PROFESSIONAL ENGINEER IN THE STATE OF CALIFORNIA AND IS QUALIFIED TO PREPARE AND SEAL THE PLANS FOR THE PROJECT DESCRIBED HEREIN.