PMA 2018-F
Unit 2

Dist.	County	Route	Postmile	Total Sheets	Sheet No.
IV	SF	56	SF	1	29

December 21, 1998

Approved for Continuity Control, 3rd Dist.

Registered Civil Engineer

Date

INDEX OF PLANS

TITLE		SHEET NO.
General Plan	Viaduct 'A'	1
Foundation Plan	Viaduct 'A'	2
Typical Bent Details	Viaduct 'A'	3
Girder Details	Viaduct 'A'	4
Deck Plan & Elevation	Viaduct 'A'	5
General Plan	Viaduct 'B'	6
Foundation Plan	Viaduct 'B'	7
North Abutment Details	Viaduct 'B'	8
Retaining Walls	Viaduct 'B'	9
Retaining Wall Details	Viaduct 'B'	10
Substation Plan	Viaduct 'B'	11
Substation Details	Viaduct 'B'	12
General Plan	Viaduct 'C'	13
Foundation Plan	Viaduct 'C'	14
North Abutment Details	Viaduct 'C'	15
Typical Bent Details	Viaducts 'B' & 'C'	16
Elevations of Bents	Viaducts 'B' & 'C'	17
Deck Plan & Elevation	Viaducts 'B' & 'C'	18
Typical Section	Viaducts 'B' & 'C'	19
Girder Details (Section 1)	Viaducts 'B' & 'C'	20
Girder Details (Section 2)	Viaducts 'B' & 'C'	21
Girder Details (Section 3)	Viaduct 'B'	22
Girder Details (Section 4)	Viaduct 'B'	23
Girder Details (Section 5)	Viaduct 'C'	24
Wing Rail	Viaducts 'A', 'B' & 'C'	25
Railing Details	Viaducts 'A', 'B' & 'C'	26
Miscellaneous Details	Viaducts 'A', 'B' & 'C'	27
Recessed Curb Faces	Viaducts 'A', 'B' & 'C'	28
Electrical Conduit Plan	Viaducts 'A', 'B' & 'C'	A
Lighting Standards	Viaducts 'A', 'B' & 'C'	B
Lighting Standard Details	Viaducts 'A', 'B' & 'C'	C
Electrical Conduit Details	Viaducts 'A', 'B' & 'C'	D
Legend		E

Revisions: Alt Bent No. 11 Viaduct 'B' (1)

STATE OF CALIFORNIA
DEPARTMENT OF TRANSPORTATION
STRUCTURE REPRESENTATIVE
CO. ENGINEER

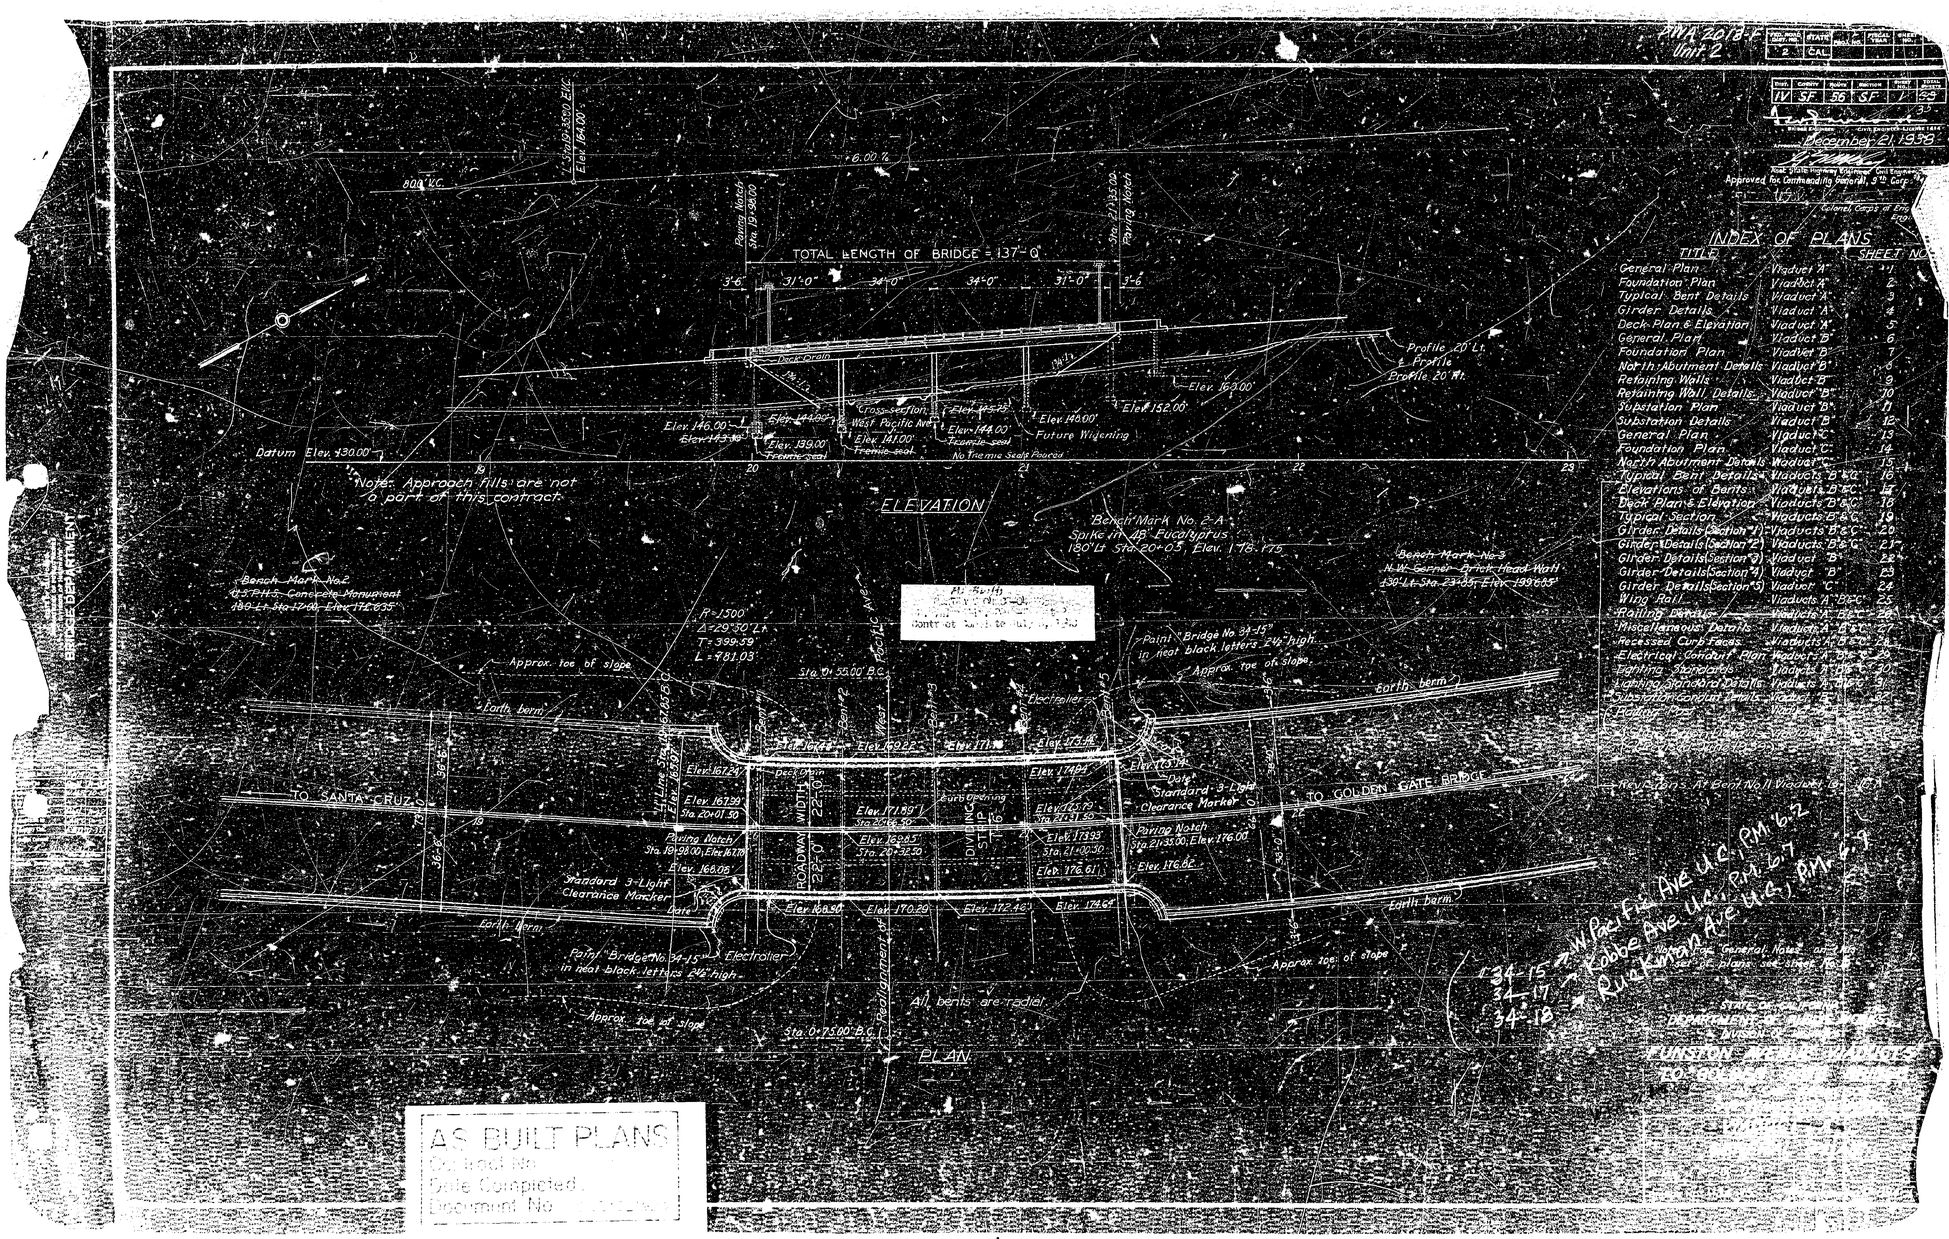

AS BUILT PLANS
Contractor
Date Completed
Document No.

PWA 20184
Unit 2

FED. PROJECT ENTRY NO.	STATE	COUNTY	PROJECT NO.	SHEET NO.	TOTAL SHEETS
2	CALIF.				

Dist.	Category	Route	Section	Sheet	Total Sheets
IV	SF	56	SF	2	39

Approved December 21, 1938
Bridge Engineer — Civil Engineer-in-Charge 1st Lt.
Approved for Commanding General 9th Corps Area
Colonel, Corps of Engineers
Engineer

BRIDGE DEPARTMENT

Temporary R/W Lines

R = 75.00'
Δ = 76°00'00"
T = 58.60'
L = 99.48'

R = 1300'
Δ = 29°50'00" L
T = 399.59
L = 761.03

Sta. 0+55.00 B.C.

Flow Elev. 174.0'

18" V.C. Culvert
Flow Elev. 175.5'

Well

TO SANTA CRUZ

℄ Line 1 — N. 30°40'16" E.

TO GOLDEN GATE BRIDGE

Note: Elevation of footings may be changed by the Engineer to suit conditions encountered in the field.
Maximum foundation pressure = 2 tons/sq. ft.

Bench Mark No 2-A
Spike in 48" Eucalyptus
180' Lt Sta. 20+05
Elev. 176.175

B.M. No. 2
U.S.P.O.S. Euc. Main 180' Lt.
Sta. 17+00 Elevation 172.635

Crossing Slab 20'-0"

Sta. 19+98.0 Paving Notch

Elev. 198.0'

Elev. 139.00' Elev. 141.00' Elev. 144.00' Elev. 148.00' Elev. 152.00'

Abandoned Well to be Back-Filled

All bents are radial

Sta. 0+75.00 B.C.

FOUNDATION PLAN
Scale 1" = 20'-0"

R = 100.00'
Δ = 86°00'00"
T = 93.25'
L = 150.10'

Sta. 21+45.0 Paving Notch

Elev. 160.0'

Sta. 21+50 Paving Notch

Sta. 21+60.0 P.V.I.

Sta. 21+70.0 E.V.C. (for transition)

Sta. 24+00.00 E.V.C. (for transition)

Sta. 24+30.0 E.V.C.

Sta. 18+85.00 B.C.

Sta. 19+17.95 E.V.C. for transition

Sta. 19+79.60 Paving Notch

Elev. 176.92'
Elev. 177.76'
Elev. 174.61'
Elev. 166.15'
Elev. 160.09'
+6.403 %
Elev. 179.90'
Elev. 176.90'
Elev. 176.00'
Elev. 172.02'
Elev. 175.14'
Elev. 178.11'
Elev. 168.01'
+6.00 % Grade
+6.00 % Grade
+6.00 % Grade
100' V.C.
100' V.C.
100' V.C.
Elev. 160.15'
Elev. 160.02'
Elev. 157.52'
Elev. 157.29'
Elev. 139.84'
Elev. 164.00'
Elev. 162.63'
Elev. 162.98'
Elev. 162.95'
Elev. 165.81'
Elev. 167.78'
Elev. 167.24'
Elev. 165.50'
Right Gutter
Left Gutter, +3.750%
Viaduct

Sta. 0+22.15 Crown

Sta. 0+75.00 B.C.

Sta. 2+24.70 Electrolier

Sta. 2+49.70 Electrolier

Sta. 3+00.00 Paving Notch

Sta. 3+00.00 Paving Notch

Sta. 3+00.00 Paving Notch

PWA. 2013 F
Unit 2

FED. PROJECT NUMBER	STATE	COUNTY	ROUTE	SHEET	SHEETS
2	CAL.	IV SF	56	5	5

Approved for Commanding General
9th. Corps Area
Colonel, Corps of Engineers
Engineer
December 1935

BRIDGE DEPARTMENT

Class 'A' P.C.C. Structure
(Bents #1, #2 and #3 only)

Class 'A' R.C.C. Structure
Bents #1, #2, #3

Railing not shown

25'-6"
22'-9"
2'-9"
2"
2'-3"
4"
3'-3"
5'-0"
4-1¼"ᵘ (AB₂) bars — 36'-3" long.
8'-0"
(AB₁)
Railing not shown
6% Grade
9"
R-24'-0"
5'-4"
5'-6"
2-(AB₅) bars, Total 4 each column
2-1¼"ᵃ (AB₂) bars — 45'-0" lng. Total 4
4'-0"
⅝"ᵘ (AB₃) stirrups @ 16" ctrs.
2-1¼"ᵃ (AB₂) bars ← 22'-0" lng
2-1¼"ᵇ (AB₂) bars ← 30'-6" lng.
Total 4
4'-3"
2-(AB₄) bars
1-(AB₂) bars
2-(AB₂) bars
½"ᵘ (AB₃) hoops, @ 12" ctrs.
2-1"ᵘ (AB₂) bars
3-1"ᵃ (AB₂) bars
1-1"ᵘ (AB₂) bar
Note: Soffit of cap to be on a straight grade between outside of exterior girders. Gunite ceiling is not shown.
(AB₃) hoops
2-(AB₂) bars
1-(AB₂) bar
5'-0"
2'-0"
22'-0"
2'-0"
22'-0"
Splice (AB₂) bars alternate splices.
½"ᵘ (AB₃) stirrups @ 12" ctrs.
⊓, 12'-4" lg.
3-1"ᵘ (AB₂) bars, 53'-4" lg. Total 6
3'-4"
2'-10½"
2'-10½"
2'-10½"
2'-10½"
2'-10½"
2'-10½"
1"ᵘ (AB₂) dowels 5'-0" lg. Total 48 each column
Keyed construction joint
1"ᵃ (AB₂) bars, 63'-0" lg.
½"ᵘ (AB₃) bars @ 12" ctrs.
3'-7½" lg.
Splice (AB₂) bars alternate splices
(AB₂) dowels
3'-0"
30'-0"
30'-0"
Tremie Seal to be poured only if directed by the Engineer. Thickness of seal to be 0.43 of the hydrostatic head with a minimum of 1'-6". No seals poured.
PART ELEVATION
Scale: ⅜"=1'-0"
AS BUILT
Contract No. 08-08-Mun
Mun. Title 2013-F Unit 2
Contract Complete July 9, 1940
PART PLAN
Scale: ⅜"=1'-0"
(AB₂) dowels
(AB₂) bars
(AB₂) stirrups
(AB₂) dowels
(AB₂) bars
(AB₂) bars
2'-0"
2½"
2½"
1'-0"
END ELEVATION
Scale: ⅜"=1'-0"
SECTION C-C
Scale: ¾"=1'-0"

Elev. 68.30
Elev. 67.99
Elev. 67.44
70.29
69.65
Elev. 69.22
72.46
71.89
Elev. 171.18
El. 144.95
El. 139.00
Tremie Seal
BENT #1
El. 144.00
El. 141.00
BENT #2
Tremie Seal
El. 145.75
El. 144.00
BENT #3
Tremie
74.64
73.93
Elev. 173.14
76.81
75.79
Elev. 174.94
El. 144.00
BENT #4
El. 152.00
BENT #5
ELEVATIONS OF BENTS
Scale: 1"=20'-0"
4 Bent
(AB₂) ⇦ 5'-6" long.
(AB₂) bars
(AB₂) Stirrups 1'-6" lng.
(AB₂) bars
2½"
Equal Spcs.
2½"
Laitles 2½" min.
SECTION A-A
Scale: ¾"=1'-0"
2'-0"
2'-0"
2'-0"
(AB₂) bars
(AB₂) bars
(AB₂) hoops
(AB₂) bars
SECTION B-B
Scale: ¾"=1'-0"
5'-0"
2'-10"
22'-0"
2'-0"
2'-0"
½"ᵘ (AB₃) bars @ 18" ctrs. each face
Elev. 157.00
4-1"ᵘ (AB₂) bars
30'-0"
Keyed construction joint
4-1"ᵘ (AB₂) bars
CURTAIN WALL AT BENT NO. 4
PART ELEVATION
Scale: ¼"=1'-0"
(AB₂) bars
(AB₂) bars
(AB₂) dowels
(AB₂) bars
3'-0"
SECTION

A.S. BUILT PLANS
Contract No.
Date Completed
Document No.

PWA 2013-F
Unit 2

Dist.	County	Route	Section	Sheet No.	Total Sheets
IV	SF	56	SF	4	23

Bridge Engineer — Civil Engineer-Lieut. Col. U.S.A.

Approved December 21 1938

Approved for Commanding General 9th Corps Area

Colonel, Corps of Engineers
Engineer

Structure symmetrical about this ℄ except superelevation & grade.

3-⅞"ø ⑤ bars

3-¾"ø hoops 6'0" lg. under each Curb

1-1½"ø ⑥ bar 10'-6" long.

2-1½"ø ⑥ bars 29'-0" long.

81'-0"

6"x6" fillets

2-1½"ø ⑤ bars, 21'-0" lg. Exterior girders
3-1½"ø ⑤ bars 21'-0" long. Interior girders
2-1½"ø ⑤ bars 24'-0" long.

2-1½"ø ⑤ bars, 14'-0" lg.

2-1"ø ⑤ bars 17'-6" long.

34'-0"

3-⅞"ø bars, aft. 52'-10" lg. Splice 26'-5"

¾"ø stirrups @ 12" ctrs. between girders

13'-9" long

2-1½"ø ⑤ bars, 22'-6" lg.

2-1½"ø ⑤ bars 31'-0" long, Interior girders
Exterior girders

3-1½"ø ⑤ bars 37'-3" long, Interior girders
Exterior girders

2-1½"ø ⑤ bar 20'-0" long, Interior girders only.

2-1½"ø ⑤ bars 27'-0" long.

2-1½"ø ⑤ bars 40'-0" long.

Stirrup Spacing

Bent #1 — Bent #2 — Bent #3

NOTE:—
Girders are on curves parallel to ℄ Roadway.
Dimensions shown are for center girder.
Reinforcing is typical for all girders except as noted.

GIRDER ELEVATION
Scale: ⅜"=1'-0"

⑤ bars @ 18" ctrs

20' 32'-0" long 24'-6"
28'-3" 34'-3"
26'-4" 26'-4" 52'-8" long

54'-3" long
54'-3" long

Symm. about ℄ except as shown

25'-6"

22'-0"

10" x 14" sheet ctrs @ 18" ctrs

Splice of reports ⑤ bars on tapered Splice of 2 girders

4 Galvanized wire hangers @ 24" ctrs each

Strap hangers "See detail"

Splice of bars

1" bars @ 12" ctrs

½" x 6" Plate

½" Girders

Note: Omit ceiling between end diaphragms and end bents.

1½"x¾"x⅛" Galvanized ℄'s @ 2'-6" ctrs.

TRANSVERSE SECTION Ⓐ Ⓐ
Scale ½"=1'-0"
NORMAL TO ℄ OF BRIDGE

Ceiling Notes.
Expanded metal mesh cut from 18 ga. galvanized sheets and expanded to 1½"x3" mesh Wt = 36" lbs/sq. yd. Metal mesh to be lapped 1½" mesh at joints. Metal mesh to be placed 3" below backing and fastened to each ℄ intersection and to each channel @ 6" ctrs. with 18 ga. double annealed galvanized wire.

Inside face of exterior girder

14 ga. double annealed wire @ 12 ctrs.

Channel

Backing

Metal Mesh Lath

Gunite

SECTION Ⓒ Ⓒ
No scale

¾"x1" Douglas blocking on 2"x6" cleats

Concrete form

DETAIL OF STRAP HANGERS
Scale 1"=1'-0"

AS BUILT
Contract Complete July 5, 1940

Grout

7/8" hole
1¼" spacer bar

½" bars @ 18" ctrs

3'-0" long

1¼" spacer bar

2-1" bars 6'-0" long

Slab

Grout

½"ø dowels @ 18" ctrs. 1'-6" long

CURB DETAIL
Scale: 1"=1'-0"

Chief of Sections

1'-5"

4'-0" lg.

¾" Stirrups

2'-0"

5'-1'-6" lg.

FUNSTON AVENUE APPROACH
TO GOLDEN GATE BRIDGE
VIADUCT
SUPERSTRUCTURE
General Plan

AS BUILT PLANS
Sheet No.
Dist. Drawing No.
Spec. Book No.

PWA 2013 F
Unit 2

FED. HWY. DIST. NO.	STATE	NO.	FISCAL YEAR	SHEET NO.
2	CAL.			

DIST.	COUNTY	ROUTE	SECTION	SHEET NO.	TOTAL SHTS.
IV	SF	56	SF	3	35

December 21, 1938

Approved for Commanding General
9th Corps Area

Colonel, Corps of Engineers
Engineer

BRIDGE DEPARTMENT

Bent No. 1	F-1
Bent No. 2	F-2
Bent No. 3	F-3
Bent No. 4	F-4
Abut. No. 1	A-1
Abut. No. 5	A-5

Bent No. 5 F-5

Electrolier

8" Deck drain & Grate

Cross-section of realignment of West Pacific Avenue.

Proposed future widening

Datum Elev. = 143.00

Bent #1

Bent #2

Bent #3

℄ 20+50

ELEVATION

3"x 24" Curb Opening

Mesh Reinforcement

½"ϕ "spacer" bars continuous between paving notches

⅜"ϕ distribution bars. continuous between paving notches

1500 R

Not in this contract

⅝"ϕ ⓢ bars @ 15" ctrs. measured on ℄, str.

Crop 8'-0"

⅝"ϕ ⓢ bars @ 15" ctrs. measured on ℄, str.

Roadway ℄ Viaduct symmetrical about this line except for differences due to curvature and superelevation.

¾"ϕ ⓒ bars @ 15" ctrs. measured on ℄

¾"ϕ ⓒ bars @ 15" ctrs. measured on ℄

¼"x 6" wire @ 6" spacing in 8'-0" width sheet top of slab Bents #2, 3 & 4

½"ϕ stirrups @ 12" ctrs. between girders, U = 13'-9" lg.

68 spaces @ 5" on ℄ = 28'-4" on ℄

73 spaces @ 5" on ℄ = 31'-3" on ℄

⅝"ϕ ⓢ bars @ 15" ctrs. measured on ℄

⅝"ϕ ⓢ bars @ 15" ctrs. measured on ℄

½"ϕ bars @ 18" ctrs. between spacers over piers. Alternate 6'-0" and 9'-0" lg. Top of slab Bents #2, 3 & 4

See sheet No. 25 for End Post detail

¾" Expansion Joint in curb and end post.

¼" expansion joint in curb at each bent as close to ℄ of bent as rail post spacing will permit.

Viaduct symmetrical about this line except for differences due to curvature and superelevation.

SLAB TOP STEEL

SLAB BOTTOM STEEL

PART DECK PLAN

AS BUILT PLANS
Contract No.
Date Completed
Document No.

AS BUILT

EUNSTON AVENUE VIADUCT
TO GOLDEN GATE BRIDGE
VIADUCT
DECK PLAN & ELEVATION

PWA 2013-F
Unit 2

Proj.	Account	Route	Segment	Log Mile	Segment No.
HW	SF 56	SF	6	33	

Proj. Segment Identification No.	Date	Mileage	Total	Segment No.
2	CAL			

December 21, 1938

Approved for Commanding General 9th Corps Area

Colonel, Corps of Engineers, U.S. Engineer

TOTAL LENGTH OF BRIDGE - 707'-0"

11 Spans @ 55'-0" 605'-0"

6%

60'-0" V.C.

EVC Sta 23+44.33 Elev. 224.56

Sta. 43+44.33 Elev. 224.56

44'-0"

47'-0"

Retaining Wall 59'-0"

Wingwall

Sub-station Elev. 205.00

#1 Elev. 195.00

#2 Elev. 188.00

#3 Elev. 180.00

#4 Elev. 176.00

#5 Elev. 168.00

#6 Elev. 168.00

#7 Elev. 167.00

Profile 20'1"

& Profile

#8

#9 Elev. 160.00

#10 Elev. 157.00

Elev. 160.09 Varies

#11

Profile 20' ±

#12 Elev. 159.00

#13 Elev. 160.00

Datum Line Elev. 160.0

45 46 47 48 49 50 51 52 53

Note: Approach Fills not a part of this contract

See Sheet 17

For Elevation see sheet #9

ELEVATION

B.M. No. 6A
Elevation ~~224.348~~ 222.174
Nail in 24" Eucalyptus Tree
~~155'~~ Rt. of Sta. ~~44+50~~ 45+20
~~50'~~

Bench Mark
Spike in Stump 55' Lt Sta. 52+21
Elev. 183.075

Note: Drainage installation included in this contract ends at face of drop inlet. Drop inlets and pipe ahead of this point not a part of this contract.

Point of Bridge No. 34-171 in neat black letters 2" high

Note: Drop inlets and pipe back of this point are not a part of this contract. Drainage installation included in this contract starts at face of drop inlet.

Sub-station (Under) Elev. 205.00

Standard drop inlet Sta. 41+20.0 Elev. 26.00

Standard 3 Lt. Clearance Unit

6" P.M.P. Standard drop inlet

Expansion Joint

Electrolier

Sta. 52+86.0

Elev. 183.60

42" C.M.P.

Standard drop inlet

TO SANTA CRUZ

TO GOLDEN GATE BRIDGE

Electrolier

Expansion Joint

N.O. 54' 16½"

Drain

Sta. 52+21.0

6% Merchant Casing Cross Drain

Point No. 10

Point No. 11

Point No. 12

Point No. 13

Point No. 5

Point No. 6

Point No. 8

Point No. 9

Point No. 3

Point No. 4

Point No. 2

Point No. 1

Sta. 43+44.33

Elev. 224.56

12" C.M.P. Electrolier

12" Storm Sewer Outlet

Approx. toe of slope

POST ROAD

KOBBE AVE.

KOBBE BLVD.

PARK

PLAN

AS BUILT PLANS
Contract No.
Job Compact No.
Drawing No.

AS BUILT
Contract Change Order No.
Date
Initials

BRIDGE DEPARTMENT

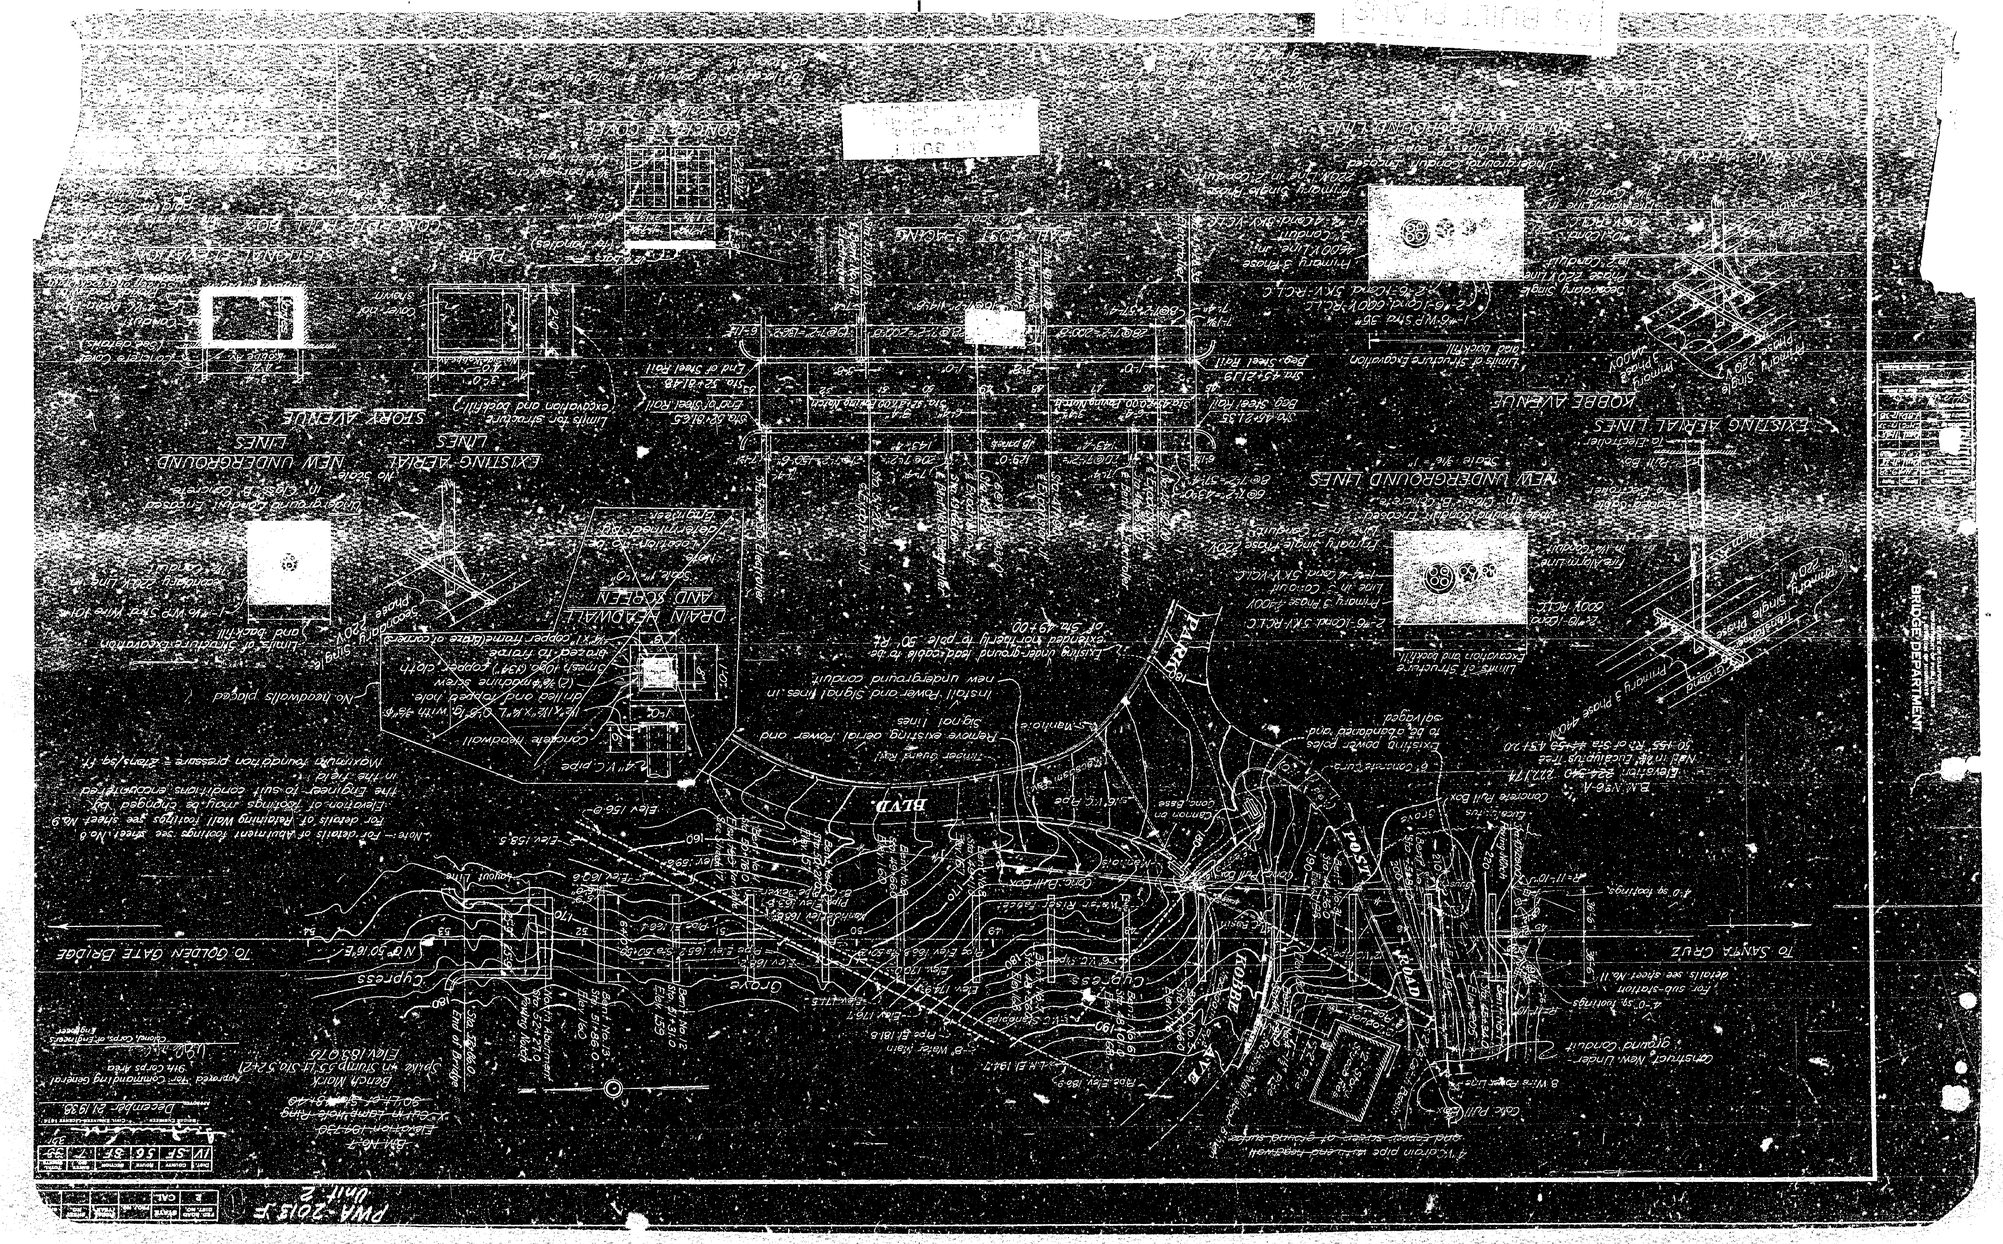
BRIDGE DEPARTMENT
PWA-2013-F
Unit 2
Sheet No. 2
December 21, 1938
Approved for Commanding General
9th Corps Area
Chief, Corps of Engineers
Engineer
Chief, Bureau of Engineering
Engineer
Scale 1" = 40'
Scale 1" = 10'
Scale 3/16" = 1'
Scale 1/16" = 1'
Scale 1/8" = 1'
Scale 1/4" = 1'
Scale 3/4" = 1'
Elevation Datum
Bench Mark
Elev 183.076
Spike in stump 3.5 ft. S. to 3.2 ft.
Elev 183.076
Bench Mark

PWA 2013 P
Unit 2

FED. ROAD DIST. NO.	STATE	PROJECT NO.	SHEET NO.	TOTAL SHEETS
8	CAL.			

DIST.	COUNTY	ROUTE	SECTION	SHEET NO.	TOTAL SHEETS
IV	SF.	56	SF.	8	32

Approved December 21, 1935
Chief, Corps of Engineers

Approved for Commanding General 9th Corps Area
Colonel, Corps of Engineers
Engineer

BRIDGE DEPARTMENT

REAR ELEVATION
Scale 1/4" = 1'-0"

Reinforcement in retaining walls not shown.

SECTION (B)(B)
Scale 1/4" = 1'-0"

SECTION (A)(A)
Scale 1/4" = 1'-0"

PLAN
Scale 1/4" = 1'-0"

ELEVATION

Abutment to be backfilled to this elevation before girders are poured.

For Retaining Wall details see Sheet No. 9

TABLE OF REINFORCING STEEL AND DIMENSIONS

"H"	22'-0"	20'-0"	18'-0"	16'-0"	14'-0"	12'-0"	10'-0"	8'-0"	6'-0"
"W"	13'-11"	12'-8"	11'-6"	10'-3"	9'-2"	8'-0"	6'-10"	5'-8"	4'-6"
"C"	6'-4"	5'-10"	5'-4"	4'-10"	4'-4"	3'-10"	3'-5"	2'-11"	2'-5"
"B"	7'-5"	6'-10"	6'-3"	5'-8"	5'-1"	4'-7"	4'-1"	3'-6"	2'-11"
"a" bars	1'-5" @ 7"	1'-3" @ 7"	1'-2" @ 7"	1'-0" @ 7"	0'-11" @ 7"	0'-9" @ 7"	0'-8" @ 7"	0'-7" @ 7"	0'-6" @ 7"
"b" bars	1'-8" @ 7"	1'-6" @ 7"	1'-4" @ 7"	1'-2" @ 7"	1'-0" @ 7"	0'-11" @ 7"	0'-9" @ 7"	0'-8" @ 7"	0'-7" @ 7"

AS BUILT PLANS
Corrections
Per Company's
Document No.

FULTON STREET AVENUE VIADUCTS
TO GOLDEN GATE PARK
SAN FRANCISCO

PWA 2013-F
Unit 2

Dist.	County	Route	Section	Sheet No.	Total Sheets
IV	SF	56	SF	9	35

Tel. Road Dist. No.	System	U.S. Highway No.	State Route No.	County Road No.	Bridge No.
2	CAL.				

Approved for Commanding General
9th Corps Area
Colonel, Corps of Engineers
Engineer

Approved: December 21, 1938

BRIDGE DEPARTMENT

PLAN East Side

PLAN West Side

ELEVATION EAST WALL

ELEVATION WEST WALL

CURB DETAIL Revised June 30, 1939

AS BUILT

AS BUILT PLANS

FUNSTON AVENUE VIADUCT
TO GOLDEN GATE BRIDGE

PWA 2013 F
Unit 2

FED. ROAD DIST. NO.	STATE	PROJ. NO.	FISCAL YEARS	SHEET NO.
4	CAL			

Dept.	District	Route	Section	Sheet No.	Sheets in Set
IV	SF	56	SF	10	35

Approved
Division Engineer — Civil Engineer — Colonel Date
Approved December 21, 1938

Approved for Commanding General
9th Corps Area

Colonel, Corps of Engineers
Engineer

DEPARTMENT OF PUBLIC WORKS
DIVISION OF ARCHITECTURE
BRIDGE DEPARTMENT

25°-3" To ℄ Highway

3'-0"
12"
2'-0"

Rail (Refer to sheet #26 for details)
Layout Line
For details of curb see sheet #9

6" Bars along top of wall

2 Dia. 1½" Min.

4" ϕ Drains @ 6'-0" ctrs. at height of outside ground. Provide suitable stone backing.

Construction joint

8 Bars

B
C
W

6" Bars
8 Bars

2 Dia. 1" Min. Step short 6" bars

Omit key when founded on rock or when so directed by the Engineer.

SECTION

El. 232.173
17'-6"
El. 230.275
El. 226.80
El. 224.94
44+73.00 ℄
45+06.25
Sta. 44+23.00
ELEV.
Scale: ¼" = 1'-0"

H = 22'-0"
H = 20'-0"
H = 18'-0"
H = 16'-0"
H = 14'-0"
H = 12'-0"
H = 10'-0"
H = 8'-0"

13'-11" Long
12'-8" Long
11'-7" Long
10'-5" Long
9'-3" Long
8'-2" Long
7'-0" Long

6 Bars straight with dowels bent into footing

30 Dia.

8 Bar dowels

Short 6 bars

6 Bars bent into footing

ELEVATION

TABLE OF REINFORCING STEEL DIMENSIONS & DATA

H.	22'	20'	18'	16'	14'	12'	10'	8'	6'
W	13'-6"	12'-4"	11'-3"	10'-2"	9'-0"	7'-11"	6'-9"	5'-8"	4'-8"
C	5'-0"	4'-6"	4'-1"	3'-8"	3'-2"	2'-9"	2'-3"	1'-10"	1'-4"
B	8'-6"	7'-10"	7'-2"	6'-6"	5'-10"	5'-2"	4'-6"	3'-10"	3'-2"
C	2'-2"	2'-0"	2'-0"	1'-8"	1'-8"	1'-6"	1'-6"	1'-6"	1'-2"
S_1	5¼	5"	4¾	4"	5½	5"	2½	2"	1¾"
S_2	1'-8¾"	1'-7½"	1'-6½"	1'-6"	1'-5¼"	1'-4½"	1'-3¾"	1'-3"	1'-2¼"
O Bars	11"ϕ @7"	11"ϕ @7"	1"ϕ @7"	1"ϕ @7"	⅞"ϕ @7"	¾"ϕ @6"	¾"ϕ @8"	¾"ϕ @8"	¾"ϕ @10"
O Bars	11"ϕ @7"	11"ϕ @7"	1"ϕ @7"	1"ϕ @7"	¾"ϕ @7"	¾"ϕ @3"	⅝"ϕ @8"	¾"ϕ @8"	¾"ϕ @10"

Note: key omitted from above quantities

PLAN
Scale: ¼" = 1'-0"

Note
East and West wall are alike.

Tunnel Wall

Bottom Elev. of footing 226.80

35'-4" from ℄ roadway

1:2

33'-3"

Sta. 45+10.25

¾" Expansion Joint Material

S.W. Wing wall Viaduct "B"

Bottom Elev. of footing 226.94

½" ϕ stirrups @ 12" ctrs.

½" ϕ spacers

3'-0"

1'-7"

Roadway

Surface

½" ϕ spacer bars

½" ϕ bars @ 12" ctrs.

Footing Elev. as given in Plan.

TYPICAL SECTION OF WALL
Scale: 1" = 1'-0"

CONNECTION WALLS TO TUNNEL

W
C
B
½" ϕ Spacer bars

1" Expansion joint, fill with premolded expansion joint filler joint to extend throughout height of wall only, locate joints at 20'-0" ctrs. or as directed by the Engineer.

PLAN ONE EXPANSION JOINT

Sheet Copper #22 Stub Beaded

1" Dia.

1" Sheet Expan. fill

Sheet Copper #22 Stub Beaded

1" Sheet Expan. fill

COPPER SEAL

AS BUILT PLANS
Contract No.
Date Completed
Document No.

FUNSTON AVENUE PROJECT

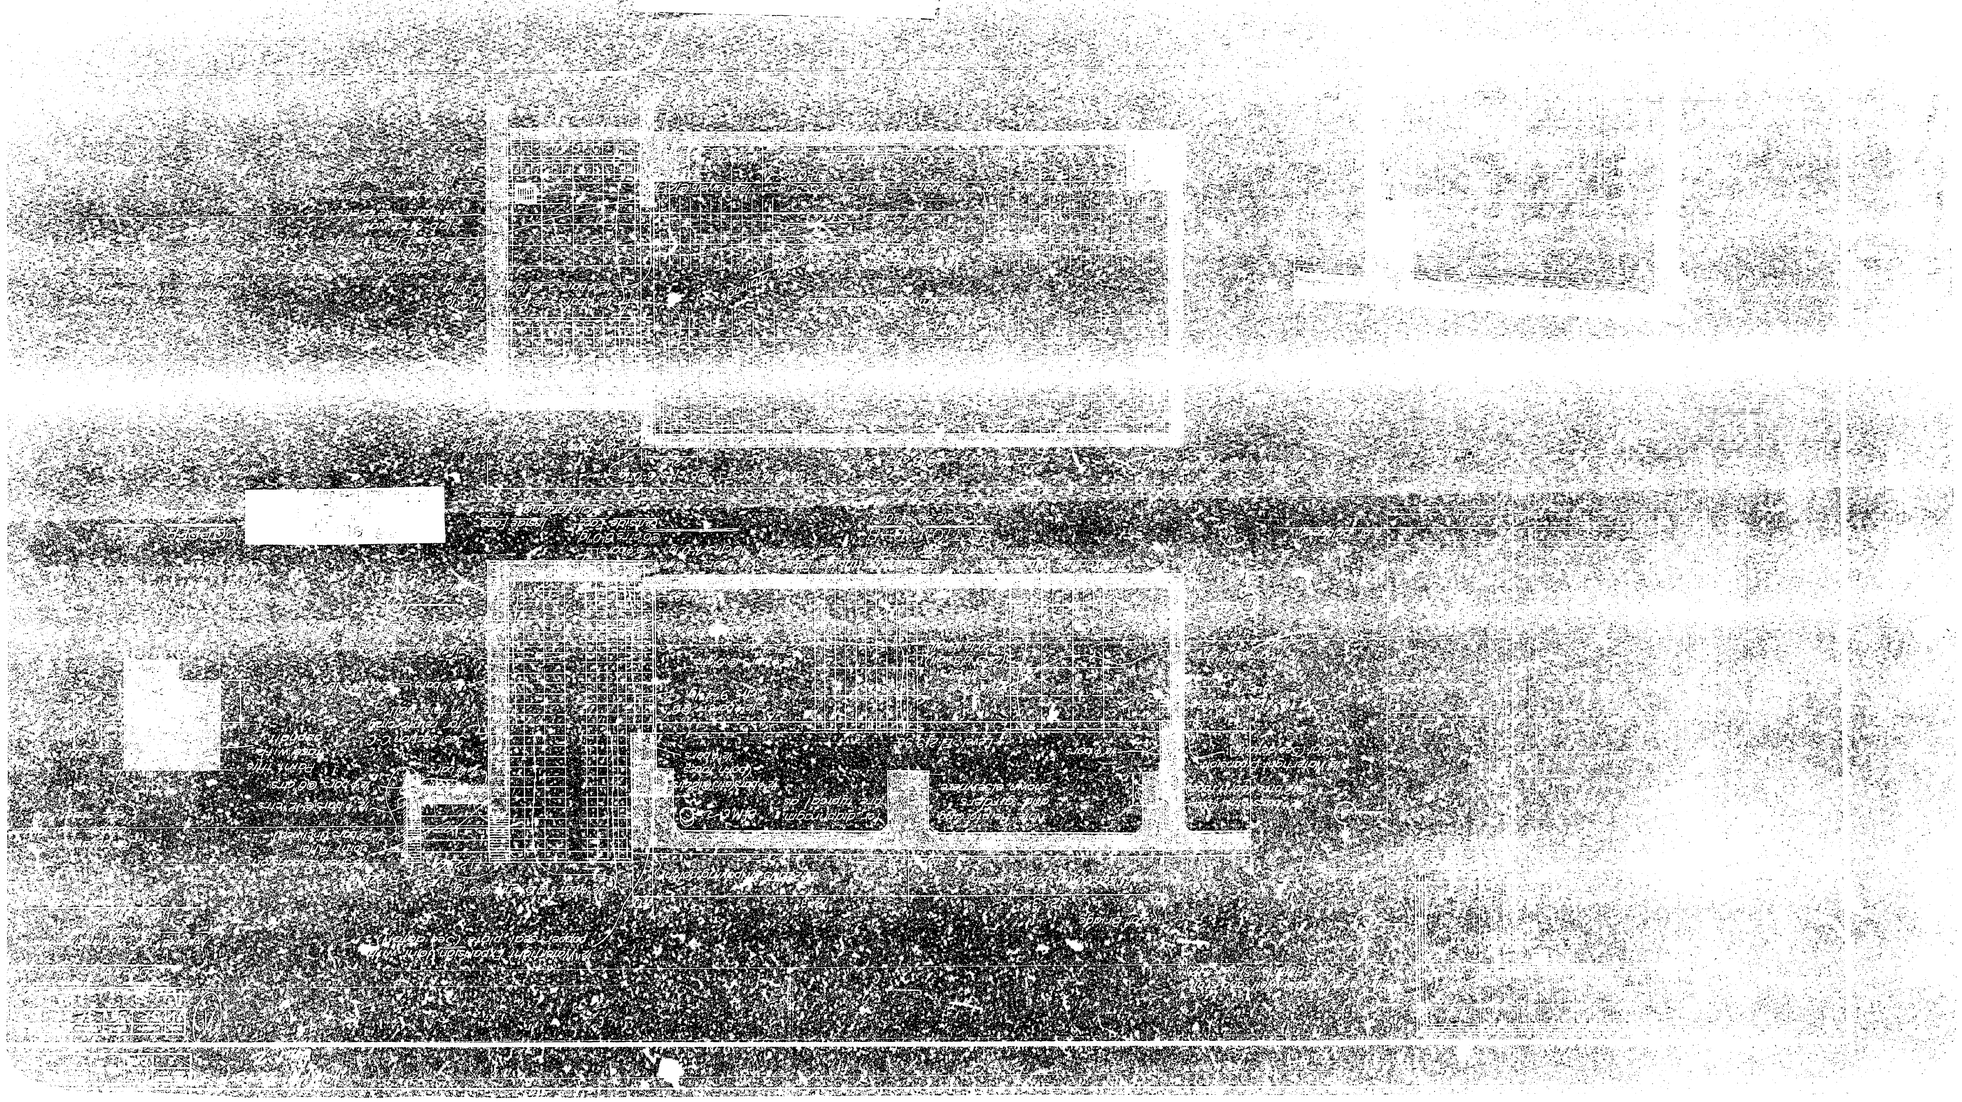

PWA 2013-F
Unit 2

FED. ROAD DIST. NO.	STATE	PROJECT NO.	SHEET NO.	TOTAL SHEETS
2	CAL.			

DRWN.	CHKD.	TRACED	CHKD.	DATE	SUBM.
IV SF	56	SF	12		

BRIDGE DEPARTMENT

Approved December 21, 1938
Approved for Commanding General 9th Corps Area.
Colonel, Corps of Engineers
Engineer

Elev. 226.14
Slope 1"
½"ϕ bars @ 6" ctrs. 6'-0" lg.
½"ϕ bars — @12" ctrs.
¾"ϕ bar 18'-9" lg. (both faces)
½"ϕ bars — @12" ctrs. (both ways-inside face)
¾"ϕ bars — @12" ctrs. (outside face)
Railing around outside of stairs is not shown.
½"ϕ bars
Vertical reinforcing
3-¾"ϕ bars @6" ctrs.
13-⅜"ϕ bars @6" ctrs.
El. 216.81
El. 215.73
3¾" step in landing
2-¾"ϕ bars — 7'-0" lg.
2-¾"ϕ bars — 10'-0" lg.
7'-10"
Elev. 212.50
10½"
7½"
½"ϕ bars @ 6" ctrs. 10'-0" lg.
7'-5"
11'-11"
Reinforcing Outside face
½"ϕ bars 4'-5" lg. (each tread)
½"ϕ bars @12" ctrs. 7'-6" lg.

SECTION C-C
Scale ⅜"=1'-0"

Earth backfill
Rock filling material
90-10" (20-1½ of 8" Perforated Metal Pipe for sub-drains.
Inv. El. 216.8
Inv. El. 210.0
17'-0"
22'-0"
Down
Invert El. 212.4
Slope 2"
28'-0"
Inv. El. 211.5
℄ Bent No 1
Sta. 45+34
Paving Notch
Sta. 45+20
Slope ¾"
27'-0"
End 8" sub-drain
Rockdrain Pocket below Surface
℄ of Bridge

SECTION E-E

DRAINAGE LAYOUT
Scale 1"=10'-0"

2½"x2½"x⅜" tubing with cap for end post
(At 2½"x2½" end posts)
(At intermediate posts)
2½"x½"x.120" tubing for rails and intermediate posts
(At intermediate posts)
(At 2½"x2½" end posts)
Note: All exposed welds to be ground flush with outside surface.
Vertical dimensions as given on Sections C-C and F-F
Top of Wall
Posts grouted in 4"x4" holes.

DETAIL OF STEEL RAILING
Scale 3"=1'-0"

AS BUILT
CONTRACT NO. DA-04-193-CIVENG-38-1-3
P.W.A. 2013-F Unit 2
Contract Completed June 6, 1940

8" SWR connecting to sub-drain (See drainage layout)

Steel Railing 8" edge wall
3'-0"
R=40'
2'-8"
90°
Curb

PLAN OF GATE

Construction Joint
El. 225.64
2-¾"ϕ bars — 19'-0" lg.
Edger finish 6" edge wall and metal railing to continue to meet face of wing rails. Enclosed area to be covered with 4" P.C.C. sidewalk (blocked into 2:6 squares). For details of wing rail see Sheet # 25
Rise 7"
Tread 10½"
2-¾"ϕ bars 22'-0" lg.
½"ϕ bars @6" ctrs. 22'-0" lg.
½"ϕ bars — @12" ctrs. 3'-9" lg.
Steel Railing (See Sub-Station Plan for extent of railing)
2-¾"ϕ bars — 6'-6" lg.
3'-7"
½"ϕ bar 3'-9" lg. (each tread)
El. 216.81
El. 215.73
½"ϕ bars — @12" ctrs. (both faces)
14'-8"
4'-8"

SECTION F-F
Scale ⅜"=1'-0"

Note: For location of Sections C-C, E-E, and F-F see "Plan of Sub-station", sheet # 11

Built-in brass lock calling for the same key as the door key to the sub-station. Six keys to be furnished with the lock.
2'-10"
Hinge
Top of curb
Roadway
½"ϕ bars 11'-9" lg.
¾"ϕ bars 11'-9" lg.

ELEVATION OF GATE
Scale ¾"=1'-0"

Note: Steel railing and gate to be galvanized after shop fabrication is complete.

SECTION E-F
Scale ½"=1'-0"

Grating frame 1½"x1½"x¼" L mitered and welded at corners. Frame to be galvanized after assembly

PLAN OF DRAIN
Scale ½"=1'-0"

1¼"x¾" bars 9¼" lg. fix at bar

DRAIN GRATING
Scale ½"=1'-0"
Grating to fit in angle frame. Bars removable. Grating to be galvanized after assembly

FUNSTON AVENUE VIADUCT
Project No. [illegible]
Roadway [illegible]
Sheet No. [illegible]

AS BUILT PLANS
Contract No
Date Completed
Document No

PWA 2013-F
Unit 2

DIST.	COUNTY	ROUTE	POST MILE	SHEET NO.	TOTAL SHEETS
IV	SF.	56	5.A	15	59

December 21, 1932

Approved for Commanding General
9th Corps Area
[signature]
Colonel, Corps of Engineers
Engineer

BRIDGE DEPARTMENT

Sta. 52+23.00
Elev. 165.54

Grade -6.00%

TOTAL LENGTH OF BRIDGE = 444'-0"
7 spans @ 55'-0" = 385'-0"

18'-0"

41'-0"

Sta. 59+67.00
Elev. 138.30

Profile 20' Lt.
Profile ℄
Profile 20' Rt.

144.3
El. 146.0

Bench Mark
Spike in Stump 53' Lt. Sta. 55+21
Elev. 166.647

Bent No. 1

El. 134.0
El. 131.0
El. 126.0
El. 118.0
El. 110.0
Grade
El. 121.13
El. 106.0
El. 109.0
El. 113.0

Datum Elevation 100.00

Retaining Wall built under previous contract

Treated timber piles
Ave. length for estimating 30'
Size Shell 14 for rest piles

B.M. No. 8
Nail at base of 18" Pine
137' Lt. Sta. 55+85
Elev. 163.505

Note: Approach fills not a part of this contract.

Sta. 58+52.00 ℄ of
Story Ave. Relocation

ELEVATION

B.M. "9"
Nail at base of 24" Eucalyptus 65' Lt.
Sta. 60+37 Elev. 128.335

Note: Drop inlets and pipe back of this point not a part of this contract. Drainage installation under this contract begins at face of drop inlet.

AS BUILT
CONTRACT DA-05-ON-203
U.S. Hiwy. 101-F Unit 2
Cont. ot Complete July 6 1940

Relocation of Story Ave.

STORY

Drainage installation under this contract ends at face of drop inlet. Drop inlets and pipe ahead of this point are not a part of this contract.

Paint Bridge No. 34-18 in neat black letters 24" high

Standard 3 Light Clearance Marker

Approx. toe of fill

Approx. top of excavation

Approx. toe of fill

Berm 1' high

18'-0"

Sta. 53+23.00

Electrolier

Expansion Joint

12" C.M.P.

Deck Drain

Electrolier

12" C.M.P. (drain)

Drop Inlet

Sta. 55+28.00
Elev. 165.54

N-0°-50'-16"-E 55

TO SANTA CRUZ

Date
12" C.M.P.

Standard 3 light clearance marker

Drop Inlet

Berm 1' high

ROADWAY WIDTH
22'-0"

DIVIDING STRIP
16"

Deck drain

Electrolier

5-⅝" Merchant Casing Cross Drain

Bent No. 1
Bent No. 2
Bent No. 3
Bent No. 4
Bent No. 5
Bent No. 6

Paint Bridge No. 34-18 in neat black letters 24" high

PLAN

Drop Inlet

Retaining Wall built under previous contract

TO GOLDEN GATE BRIDGE

LINCOLN

AS BUILT PLANS
Contract No.
Date Completed
Document No.

Br. 34-18

AS BUILT PLANS
Contract
Date
Approved

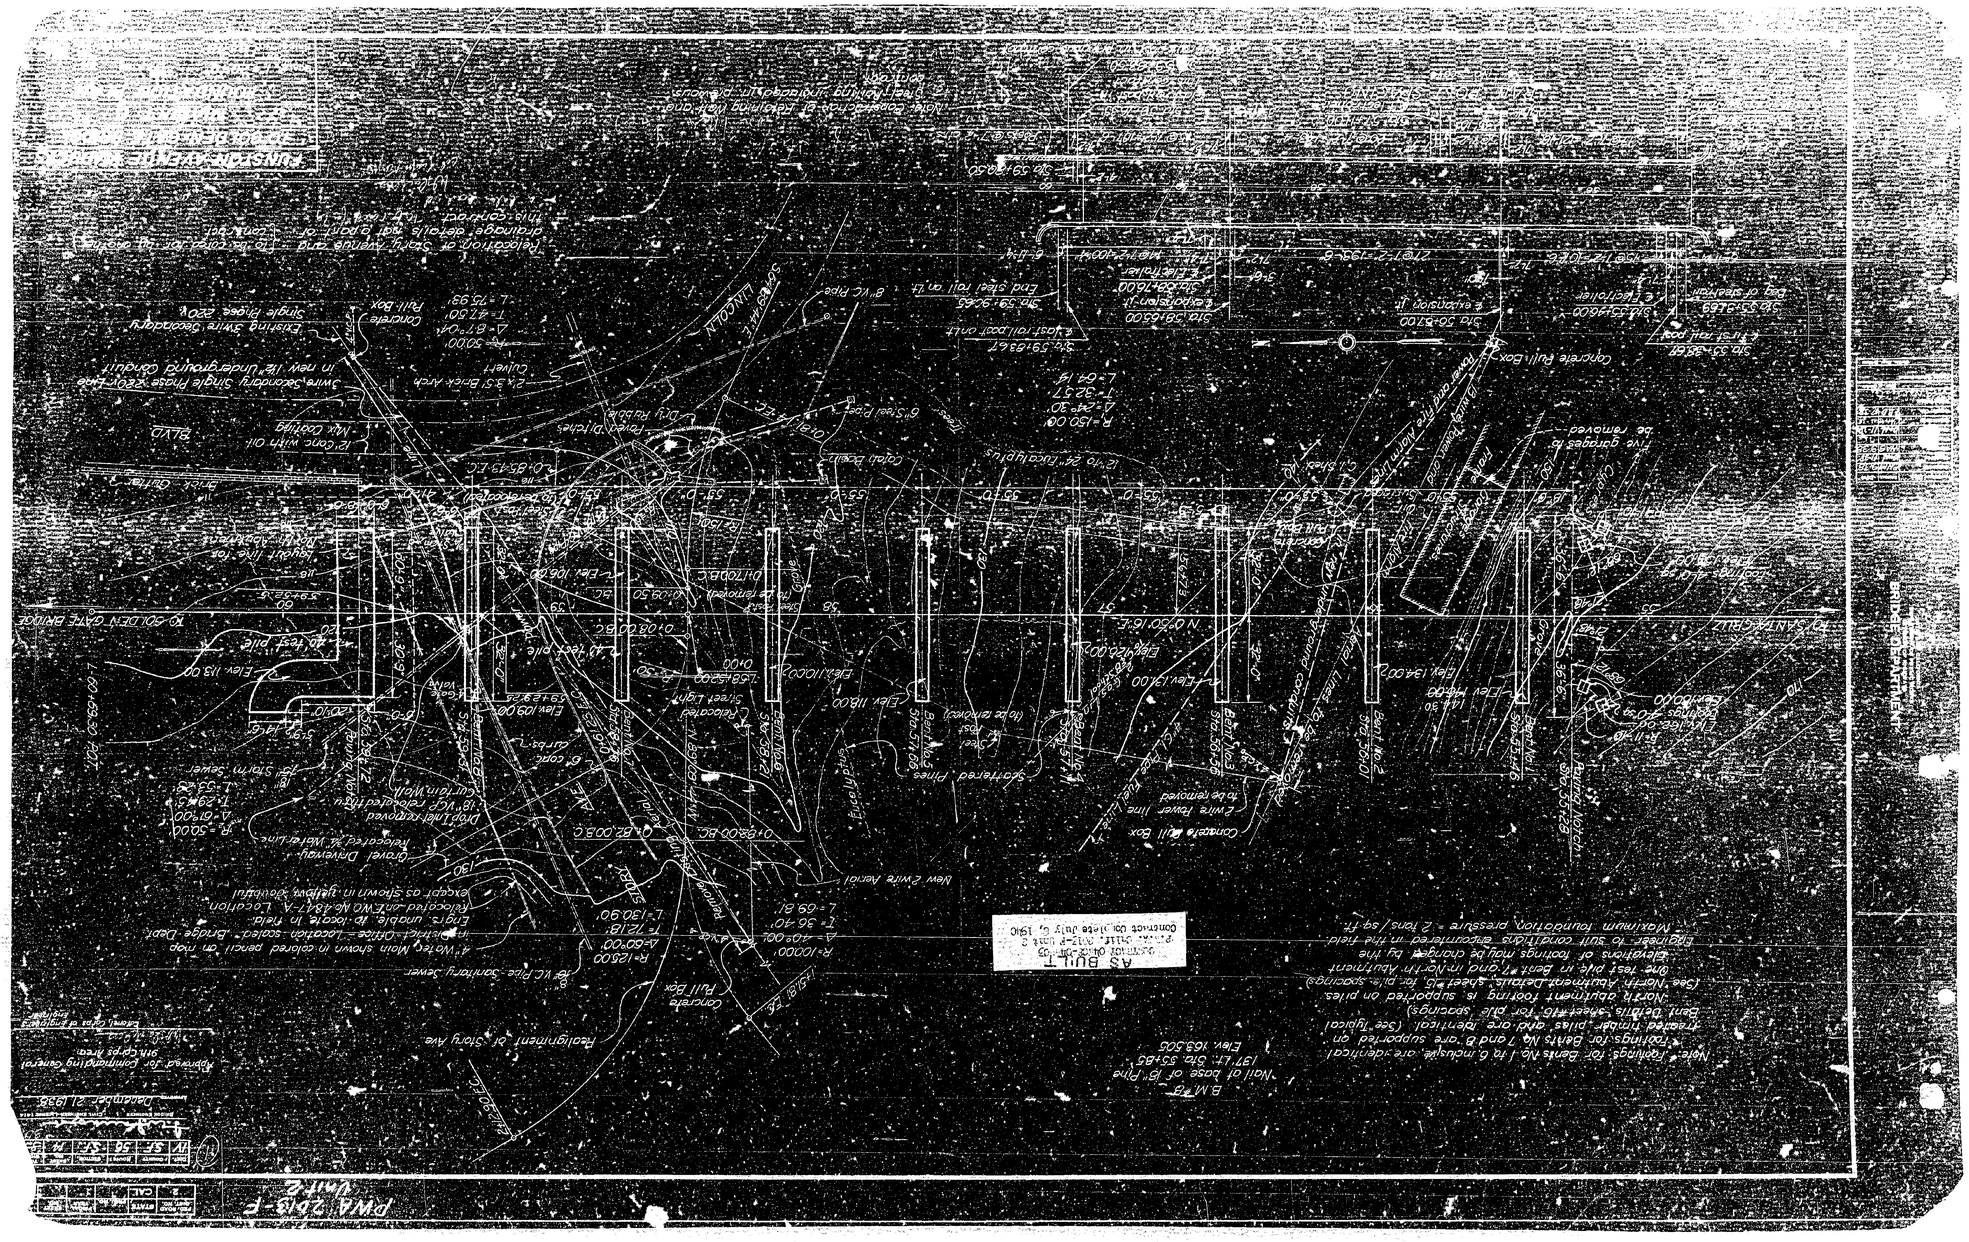
Note: Foundations for Bents No. 1 to 6, inclusive, are identical.
Footings for Bents No. 7 and 8 are supported on
treated timber piles and are identical. (See Typical
Bent Details Sheet #16 for pile spacing)
North abutment footing is supported on piles.
(See North Abutment Details Sheet #5 for pile spacing)
One test pile in Bent #7 and in North Abutment
Elevations of footings may be changed by the
Engineer to suit conditions encountered in the field
Maximum foundation pressure = 2 tons / sq. ft
Concrete Pull Box
Five garages to be removed
Lower Santa Fe Alameda
Overhead Power Lines to be removed
Concrete Pull Box
Electrolier
Bent No. 2
Bent No. 3
Bent No. 4
Bent No. 5
Bent No. 6
Bent No. 7
Bent No. 8
Retaining Wall
Footings
Piles
Elev. 124.00
Elev. 130.00
Elev. 134.00
Elev. 136.00
Elev.

PWA Form F
Unit 2

December 21 1938

Approved for Commanding General
9th Corps Area
Colonel, Corps of Engineers
Engineer

PILE RECORD FOR VIADUCT "C"

ELEVATION Make - Vulcan No.1 Steam Hammer
Scale ½"=1'0" Weight of Hammer - 5000 lbs.

Pile No.	Original Length	Ground to Place	Penetration Last Blow	Remarks
31	35'0"	18'0"	Refusal	Test Pile Bent #8 Also Longest Pile in Bent
3	20.9	12.7	12.2	7/8 inch. Shortest Pile in Bent #8
37	32.6	21.2	26.7	7/8 inch. Longest Pile in Bent #8
29	24.2	14.2	5.83	2 3/4 inch. Short Pile in Bent #8
19	26.2	16.2	1.2	10 Repaint 2 3/4 to Mud Line Under Footing 19 in Mud Footing
33	20	8.2	3.7	1/2 inch.
27	25	13.8	19.3	1/8 inch.

AS BUILT PLANS
Contract No.
Date Completed
Document No.

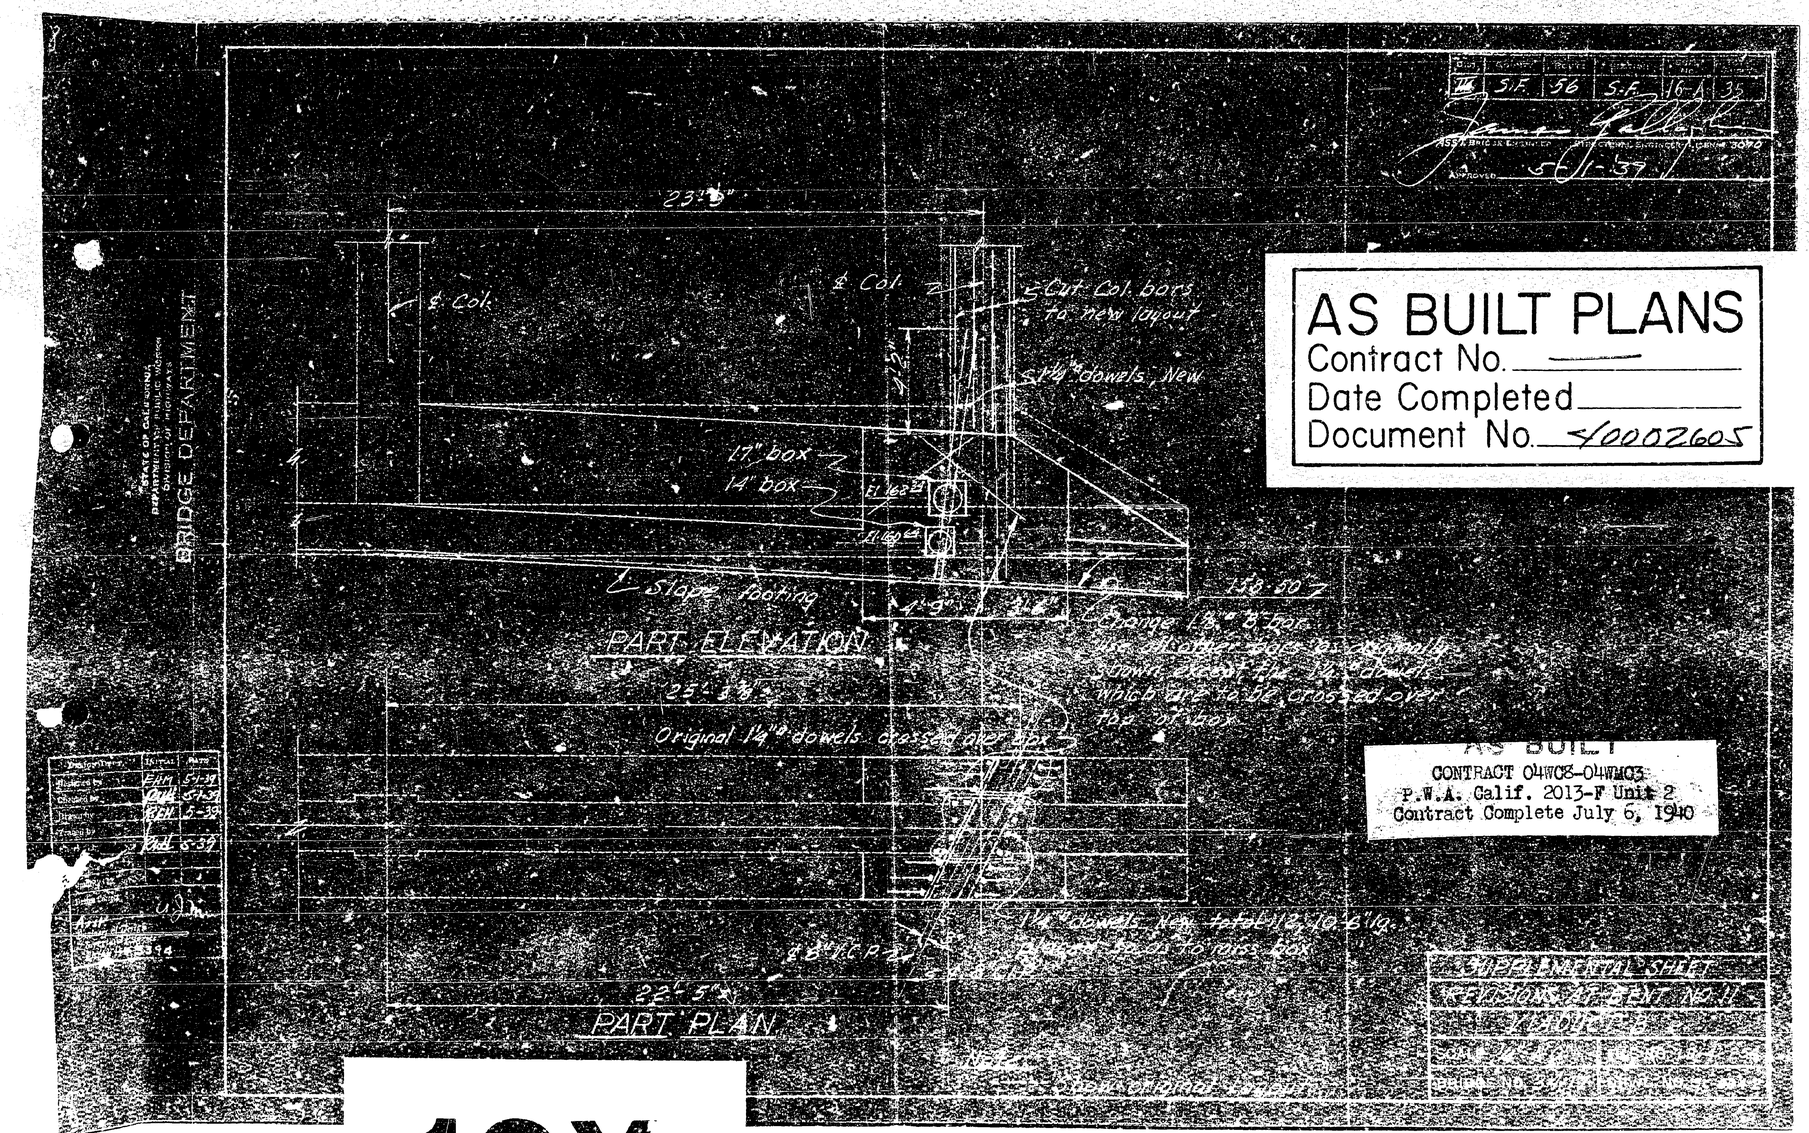
BRIDGE DEPARTMENT
STATE OF CALIFORNIA
DEPARTMENT OF PUBLIC WORKS
DIVISION OF HIGHWAYS
S.F. 56 S.F. 16-A 35
APPROVED 6-11-37
AS BUILT PLANS
Contract No. ——
Date Completed ——
Document No. 40002605
23'-5"
& Col.
& Col.
& Cut Col. bars to new layout
5-#9 dowels, New
17" box
14" box
El 162.22
El 160.22
Slope footing
PART ELEVATION
25'-3"
Original 14" dowels crossed over top
138.80
Change 15" to 8 box
AS BUILT
CONTRACT 04WC8-04WMC5
P.W.A. Calif. 2013-F Unit 2
Contract Complete July 6, 1940
14" dowels New total 13-10 x 5'lg.
22'-5"
PART PLAN
Note:
Steel in Piers Symmetrical

16X

PWA 2013-F
Unit 2

Approved: for Commanding General
9th Corps Area
December 21 1938
Colonel, Corps of Engineers
Engineer

Railing not shown.

Symmetrical about ℄ roadway

Railing not shown.

Profile grade

Radius 2'-0"

℄ Bent

Soffit level

Keyed construction joint

Concrete Structure concrete

Keyed construction joint

Keyed construction joint

Keyed construction joint

Column steel not shown

Keyed construction joint

Reinforcement similar to bents without piles.

℄ Roadway Symmetrical about this ℄

Approach Slope 3/4" to 1'-0"

Varies 3/4" min.

Keyed construction joint

Keyed construction joint

Keyed construction joint

PWA 2013-F
Unit 2

Dist.	County	Route	Section	Sheet	Total Sheets
IV	SF	56	S.F.	17	39

Fed. Aid Proj. Sheet No.	State	Project No.	Contract No.
	CAL.		

Bridge Engineer — Civil Engineer-Calif. 1416

Approved December 21, 1938

Approved for Commanding General
9th Corps Area
(Signed) Corps of Engineers
Engineer

BENT NO. 1

Bent No. 1 is typical except for special provisions for Sub-station. See "Sub-station Plans"

El. 225.18
El. 205.00

BENT NO. 2

El. 222.36
El. 195.00

BENT NO. 3

El. 219.06
El. 188.00

BENT NO. 4

El. 215.76
El. 180.00

BENT NO. 5

El. 212.46
El. 176.00

BENT NO. 6

El. 209.16
El. 169.00

BENT NO. 7

El. 205.86
El. 168.X

BENT NO. 8

El. 202.56
El. 167.00

BENT NO. 9

El. 199.26
El. 163.0

VIADUCT "B"

BENT NO. 10

El. 195.96
El. 157.00

BENT NO. 11

El. 192.66
El. 160.00
El. 160.00
El. 158.50

BENT NO. 12

El. 189.36
El. 158.00

BENT NO. 13

El. 186.06
El. 160.00

BENT NO. 2

El. 161.6
El. 134.00

BENT NO. 3

El. 157.96
El. 131.00

BENT NO. 4

El. 154.56
El. 128.00

BENT NO. 5

El. 151.26
El. 118.00

VIADUCT "C"

BENT NO. 6

El. 141.96
El. 110.00

BENT NO. 7

El. 144.66
El. 106.00

BENT NO. 8

El. 141.36
El. 109.00

BENT NO. F

El. 164.46
El. 146.90 (14.3)

AS BUILT
CONTRACT 04.08-04.05
P.W.A. Calif. 2013-F Unit 2
Contract complete July 6, 1940

AS BUILT PLANS
Contract No.
Date Completed
Document No.

FUNSTON AVENUE VIADUCT
SAN FRANCISCO - CALIFORNIA
VIADUCTS "B" & "C"
ELEVATIONS OF BENTS
PLAN NO. 2
SHEET NO. 2

BRIDGE DEPARTMENT

PWA 2013-F
Unit 2

FED. ROAD DIST. NO.	STATE	COUNTY	PROJECT NO.	SHEET NO.
2	CAL			

DIST.	COUNTY	ROUTE	SECTION	SHEET	TOTAL SHEETS
IV	SF	50	SF	78	93

December 21, 1938

Approved for Commanding General
9th Corps Area
U.S. Army Corps of Engineers
Engineer

(Retaining Wall (Built under previous contract). Viaduct "C" only.

AS BUILT
CONTRACT No. 08-98103
Federal-Aid Proj. No. 2013-F Unit 2
Contract accepted July 7, 1941

Approx. ground surface

ELEVATION

22'-0"

℄ of Bent

℄ of Bent

Center line of Roadway

Mesh reinforcement 6"x6" mesh #6 - #6 gage. Lap 3 - 8'-0" widths to make total width 22'-0". Lap each strip 12". To be placed over each bent cap.

Footing Notch
Sta. 23+27.00 (B)
Sta. 39+12.00 (C)

℄ of bridge. Symmetrical about this ℄ except slab bar splices and merchant casing.

5 bars

1/2"ϕ spacer bars

5/8"ϕ distribution bars

1"ϕ Bars @10 cts. 6'-0" long. (between girders)

5/8"ϕ Bars @18" cts. 10'-0" long. (between girders)

22'-0"

35'-6"

35'-9"

BOTTOM SLAB REINFORCING

55'-0"

TOP SLAB REINFORCING

41'-0"

DECK PLAN

1/2"ϕ bars @18" cts. 22'-0" lg. (between girders)
1/2"ϕ bars @18" cts. 12'-0" lg. (between girders)

1/4 Expansion joint in curb as close to ℄ of each bent as rail spacing will permit.

Batter 1/4 in 1'

Viaduct "C"

For bar and splice details see "Typical Section" Sheet No. 16

For location of rail posts see Sheet No. 17

AS BUILT PLANS
Change No.
Date Completed
Document No.

FUNSTON AVENUE VIADUCTS
TO GOLDEN GATE BRIDGE
VIADUCTS "B" & "C"
DECK PLAN AND ELEVATION

BRIDGE DEPARTMENT

PWA 2013-F
Unit 2

Dist.	County	Route	Mileage	Sheet	Total Sheets
IV	SF	36	SF	20	

Bridge Division

San Francisco, California
December 21, 1938

Approved for Commanding General
9th Corps Area
U.S.P.
Colonel, Corps of Engineers
Engineer

22'-0"

78'-0"

18'-0"

3-1¼"ⓐ bars, str., 36'-0" long
3-1¼"ⓑ bars, ⌒ 38'-0" long
2-1½"ⓒ bars, str., 21'-0" long
2-1½"ⓓ bars, ⌒ 22'-0" long

2-1¾"Ⓐ bars ⌒ 30'-0" long

3'-0" 5'-0" 5'-6" 5'-6" 5'-0" 3'-0"

3'-4"

-6 %

2-1¾"Ⓘ bars, str., 25'-8" long

6" fillets

3-1¼"ⓐ bars, ⌒ 44'-0" long
3-1¼"ⓑ bars, ⌒ 38'-0" long
2-1½"ⓒ bars, ⌒ 35'-0" long

Construction Joint, for details see sheet No 23

3-1¼"ⓐ bars, str. 13'-4" long

Construction Joint, for details see sheet No 23

3-1¼"ⓐ bars, str. 45'-0" long
3-1¼"ⓑ bars, ⌒ 43'-0" long
2-1½"ⓓ bars, ⌒ 35'-0" long

17'-6"

4'-0"

9'-2"

1'-3" 1'-3"

2'-2"

4'-0"

12'-0"

6 Sp. @ 3'-0" 2 @ 1'-0" 2 @ 1'-3" 3 Sp. @ 1'-6" 6 Equal Spaces 3 Sp. @ 1'-6" 2 @ 1'-3" 2 @ 1'-0" 6 Sp. @ 3'-0" 4½" 2'-6" 4½" 6 Sp. @ 3'-0" 3 Sp. @ 1'-0" 3 Sp. @ 1'-3" 3 Sp. @ 1'-6" 2 Sp. @ 2'-0" 4 Equal Spaces

Expansion Joint

⅝" Stirrups ⊓ 5'-0" long
⊔ 11'-10" long

This span symmetrical about ℄

44'-0"

27'-6"

27'-6"

Note:— Reinforcing for exterior Girders same as for interior girders except as noted below.

℄ Span	℄ Bent	℄ Span	℄ Bent (Symmetrical about this bent ℄)
3-ⓐ bars	3-ⓐ bars	3-ⓒ bars	3-ⓐ bars
3-ⓑ bars	3-ⓑ bars	3-ⓓ bars	3-ⓑ bars
No ⓓ bars	No ⓒ bars	No ⓓ bars	No ⓒ bars
	2-Ⓔ bars		2-Ⓔ bars

℄ Bents #3 & 9 Viaduct "B"
℄ Bent #2 Viaduct "C"

℄ Bents #4 & 10 Viaduct "B"
℄ Bent #5 Viaduct "C"
Section No. 1 symmetrical about this ℄

Bent No 1 | No 2 | No 3 | No 4 | No 5 | No 6 | No 7 | No 8 | No 9 | No 10 | No 11 | No 12 | No 13 | N. Abut.

Expansion Joints

VIADUCT "B"

Section No 1 | Section No 2

Expansion Joints

VIADUCT "C"

Pour No. 1
Pour No. 2
Pour No. 3

Note:— Any one section may be poured complete before starting pours in other sections providing the individual pours are made in the order as shown, except as the Expansion Bearing details govern.
No falsework is to be removed in any span until the two adjacent consecutive spans, or both ends have been completely poured and the last concrete placed in these spans has been cured according to the Standard Specifications.

KEY TO SECTIONS AND POURING DIAGRAM
No scale

INTERIOR GIRDER DETAILS
SECTION NO. 1
Scale: ⅜"=1'-0"

1"ⓖ bars
⅝" Stirrup ⊓ 5'-0" long
⊔ 11'-10" long
2'-0"
See note below
4'-0"
1½"ⓖ bars
Varies 2" min.
2 Seq. spcs.

SECTION A-A

⅝" Stirrup ⊓ 5'-0" long
⊔ 11'-10" long
2'-0"
See note below
4'-0"
Varies 2" min.
2 Seq. spcs.

SECTION B-B

⅝" Stirrup ⊓ 5'-0" long
⊔ 11'-10" long
Ⓘ bars
2'-0"
4'-0"
2 Seq. spcs.

SECTION C-C

Scale ½"=1'-0"

Note:— Depth of Exterior, Interior and Middle girders differ by the amount of the crown slope between girders.
Exterior girder depth = 5'-0"
Intermediate girder = 5'-1½"
Middle girder = 5'-3"
Reinforcing steel depth is the same for all girders.

AS BUILT PLANS
Changes
Not Required
See Field Notes

FUNSTON AVENUE VIADUCT
SAN FRANCISCO, CALIFORNIA

PWA 2013-F
Unit 2

Sheet	Number	Sheets	Number	Job	Number
IV	SF-56	SF-	21	SF-	23

December 21, 1938.

Approved, for Commanding General
9th Corps Area

Colonel, Corps of Engineers
Engineer.

BRIDGE DEPARTMENT

50'-0" Arc
5'-6" Intermediate arcs
2'-6" Middle arcs

1-1¼"ⓚ bar, 35'-6" long
2-1¼"ⓙ bars, 42'-9" long
3-1¼"ⓓ bars, 37'-0" long
3-1¼"ⓖ bars, 20'-0" long
3-1¼"ⓕ bars, 22'-0" long

2-1¼"ⓜ bar, str. 36'-0" long
2-1¼"ⓐ bars, str. 45'-0" long
2-1¼"ⓝ bars, 38'-0" long
2-1¼"ⓞ bars, str. 21'-0" long
2-1¼"ⓟ bars, 22'-0" long

For details of expansion joint, see sheet no. 22.

3-1¼"ⓒ bars, str. 12'-0" long
3-1¼"ⓐ bars, str. 20'-3" long

⅝" Stirrups
16 Spaces @ 6"

4 Bent No. 12, Viaduct B
No. 7 Viaduct C
6 Spa @ 9" 3 Spa @ 1'-0" 3 Spa @ 1'-3" 3 Spa @ 1'-6" 2 Spa @ 2'-0"

Construction Joint, for details see sheet No. 22

3-1¼"ⓒ bars, str. 45'-0" long
3-1¼"ⓑ bars, 43'-0" long
2-1¼"ⓓ bars, 35'-0" long

4 Equal Spaces
⅝" Stirrups 5'-0" long 11'-10" long

Construction Joint, for details see sheet No. 23

3-1¼"ⓒ bars, str. 18'-4" long

4 Bent No. 13, Viaduct B
No. 8 Viaduct C

2 Spa @ 2'-0" 3 Spa @ 1'-6" 3 Spa @ 1'-3" 3 Spa @ 1'-0" 5 Spa @ 9"

ELEVATION
INTERIOR GIRDER DETAILS

AS BUILT
REVISED "AS BUILT"
P.W.A. 2013-F Unit 2
Contract Complete July 6, 1940

Note: Reinforcement of Exterior Girders same as above except as noted below.

Reinforcement for exterior girders

2-1¼"ⓐ bars
No. ⓒ bars
2-1¼"ⓐ bars
3-1¼"ⓒ bars

℄ Bent No. 12 & 7

2-1¼"ⓟ bars
No. ⓒ bars
2-1¼"ⓐ bars
3-1¼"ⓒ bars

℄ Girder

℄ Bent No. 13 & 8

No change

3-1¼"ⓒ bars, str. 18'-4" long

No. 9 Viaduct C
℄ Bent No. 13 Viaduct B

6 Spa @ 9" 2 @ 1'-0" 2 @ 1'-3" 2 @ 1'-6" 2 Spa @ 2'-0" 2 Eq. Spaces 2 Spa @ 2'-0" 2 @ 1'-6" 2 @ 1'-3" 2 @ 1'-0" 7 Spa @ 8"

⅝" Stirrups 8'-0" long 11'-10" long

2-1¼"ⓒ bars, 34'-0" long
2-1¼"ⓐ bars, 38'-9" long
3-1¼"ⓖ bars, 37'-0" long

Construction Joint for detail see sheet No. 15

Batter 1" to 12

Batter 1" to 12

Paving Notch North Abutment

℄ Bent No. 13 & 8 ℄ Girder North Abutment

Note:- Depths of Exterior, Intermediate and Middle girders, differ by the amount of the crown slope between girders. Reinforcement same depth for all girders.

ELEVATION
INTERIOR GIRDER DETAILS

Note:- For Sections: D-D, E-E, F-F & G-G see sheet No. 23

AS BUILT PLANS
Corrected
Dec. Completion
As Built


PWA 2013-F
Unit 2

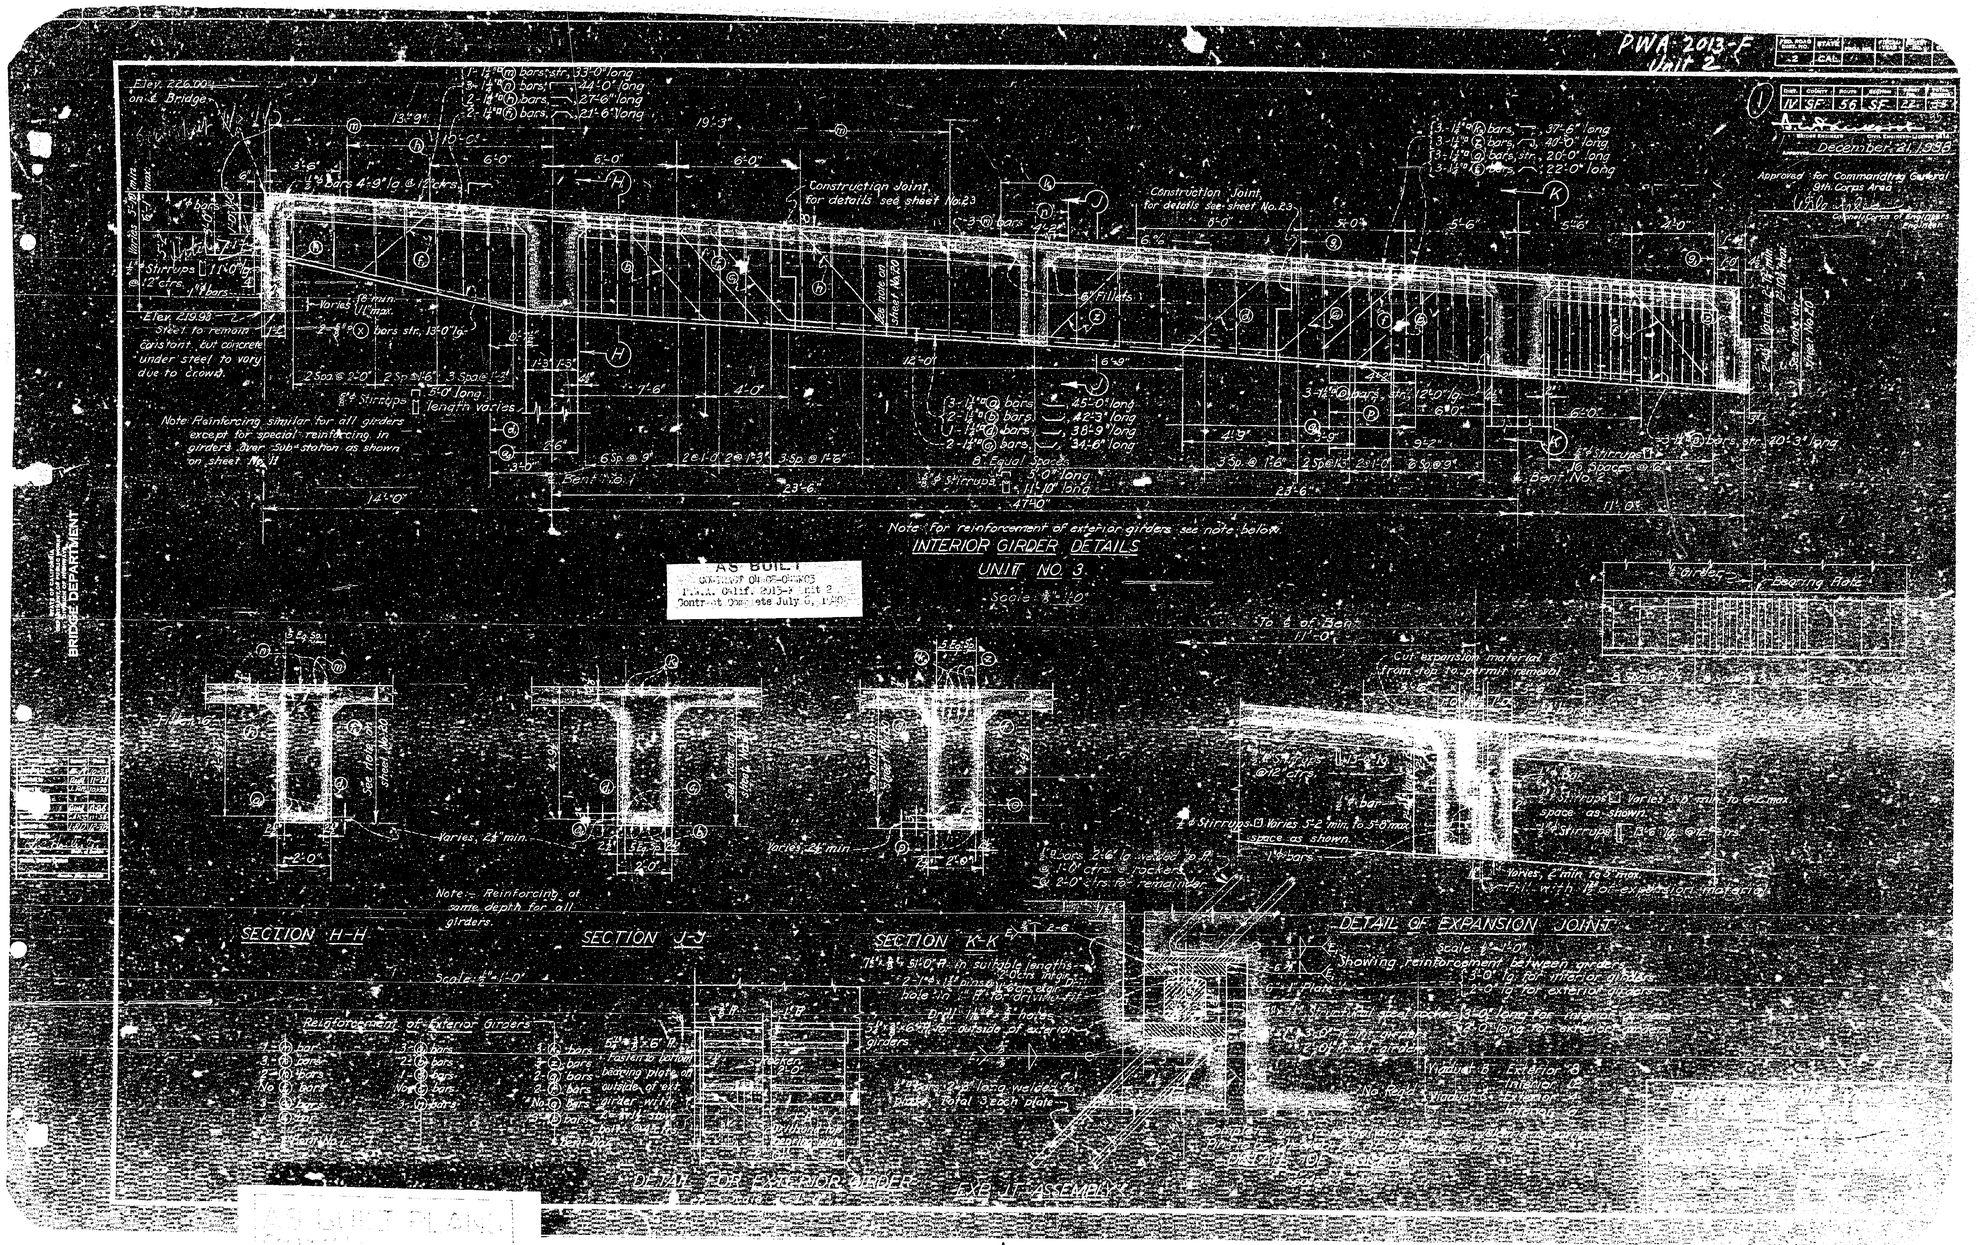

 

PWA 2613-F
Unit 2

Dist.	County	Route	Section	Sheet No.	Total Sheets
IV	SF	56	SF	24	45

Project Number	Date Prepared	Original Sheet
2	CAL	1

Approved for Commanding General
9th Corps Area
Colonel, Corps of Engineers
Engineer

December 21, 1938

3-1¼"ø (A) bars, 41'-6" long
3-1¼"ø (B) bars, 39'-0" long
3-1¼"ø (C) bars, 28'-0" long
2-1¼"ø (E) bars, 21'-6" long

3-1¼"ø (G) bars, str. 36'-0" long
3-1¼"ø (H) bars, 38'-0" long
3-1¼"ø (I) bars, str. 21'-0" long
2-1¼"ø (K) bars, 22'-0" long

2-1¼"ø (J) bars, str. 24'-4" long

3-1¼"ø (L) bars, str. 18'-4" long

3-1¼"ø (M) bars, str. 35'-6" long
3-1¼"ø (N) bars, 37'-0" long
3-1¼"ø (O) bars, str. 20'-0" long
3-1¼"ø (P) bars, 22'-0" long

3-1¼"ø (Q) bars, str. 45'-0" long
3-1¼"ø (R) bars, 40'-6" long
3-1¼"ø (S) bars, 43'-3" long

2-1¼"ø (T) bars, str. 21'-6" long

3-1¼"ø (U) bars, str. 12'-0" long
3-1¼"ø (V) bars, str. 20'-3" long
3-1¼"ø (W) bars, 22'-3" long

3-1¼"ø (X) bars, str. 45'-0" long
3-1¼"ø (Y) bars, 35'-0" long
3-1¼"ø (Z) bars, 35'-0" long

Construction Joint, for details see sheet No. 23

Bent No. 1 — Bent No. 2 — Bent No. 3 — Expansion Joint

SPAN NO. 1 — SPAN NO. 2

INTERIOR GIRDER DETAILS

Reinforcement for Exterior Girders

Note: For reinforcement of exterior girders see opposite.

Note: For Sections A-A, M-M, N-N, O-O and P-P see sheet No. 23

FUNSTON AVENUE VIADUCT

AS BUILT PLANS
Contract No.
Date Completed
Increment No.

PWA 2013-F
Unit 2

Dist.	County	Route	Section	Phase	Postmile
IV	SF	56	SF	7.5	5.7

Co. Road Dist. No.	State	Federal Aid Project No.	Sheet No.
2	CAL		

December 21, 1938

Approved for Commanding General
9th Corps Area

Colonel, Corps of Engineers
Engineer

Note: Provide opening in wall of the S.W. Viaduct B Wing Rail for a gate. (See Sht. #12)

SECTION X-X

SECTION (A)-(A)

SECTION (B)-(B)

PLAN

PLAN

ELEVATION

VIEW II For Viaducts B & C

VIEW I For Viaduct A

SECTION (C)-(C)

SECTION D-D
For Viaducts B and C

CONNECTION OF RAIL TO END POST

Note: Refer to sheet #26 for detail of other rail details.

TABLE OF DIMENSIONS

Viaduct	Wing	View	Distance "X"	Elevation "c"	Elevation "a"	Elevation "b"
A	S.E.	I	2'-10 1/2"	146.00	166.06	161.39
	S.W.	I	1'-6 7/8"	146.00	161.24	166.75
	N.E.	I	2'-10 1/2"	160.00	176.32	178.20
	N.W.	I	1'-6 7/8"	160.00	175.14	178.42
B	S.E.	II	1'-2 1/2"	213.00	225.71	224.42
	S.W.	II	1'-4 1/2"	213.00	225.71	224.42
	N.E.	See	Sheet #9			
	N.W.	See	Sheet #9			
C	S.E.	II	3'-10 1/8"	158.00	165.31	166.00
	S.W.	II	3'-8 1/4"	150.00 (162.00)	165.31	166.00
	N.W.	See	Sheet #15			

Footing B / Footing A

Note: Wing rails and end posts to be paid for as Class "A" P.C.C. Structure.

CONTRACT 04-PWA-03
P.W.A. Calif. 2013-F Unit 2
Contract completed July 6, 1940
AS BUILT

AS BUILT PLANS
Contract No.
Date Completed
Document No.

FUNSTON AVENUE VIADUCTS

P.W.A. 2013-F
Unit 2

Sheet No.	Total Sheets	Plans No.	Prints No.
2	CAL		

Work	Highway	District	Route	Section	Sheet No.
IV	1-E	56	S.E.	25	29.3

December 21, 1936

Approved for Commanding General,
9th Corps Area

Colonel, Corps of Engineers
Engineer

DIVISION OF HIGHWAYS
DEPARTMENT OF PUBLIC WORKS
STATE OF CALIFORNIA

7'-1½" between End Post & ℄ Electrolier
6'-11⅝" between End Post & ℄ Rail Post

7'-4" between ℄ Electrolier & ℄ Rail Post
7'-2" between ℄ Rail Post & ℄ Rail Post

A
Rail Post for Electrolier

PLAN
Scale: 3/4"=1'-0"

For details of Electrolier and its mounting, see sheet No. 30

See sheet #25 for connection to concrete end post

PANEL BETWEEN ELECTROLIER AND END POST

ELEVATION
Scale: 3/4"=1'-0"

PANEL BETWEEN ELECTROLIER AND STANDARD RAIL POST

AS BUILT
Corrected Changes Noted
Public Works Office
Contract Completed July 6, 1940

⅜" Cap
2"ø x 9/16" I.P. @ 1'-0"
2" ø Steel Tubing
2"ø x 9/16" I.P. @ 1'-0"
Top of Concrete
4"x4"x⅜" Steel Rail Post
⅝" bars 'D' around each post
2" Grout
Rammed Sand
⅜"x4"x3'-3" Steel Tubing
6" Grout Deck
2-⅝" bars
2"
7"
1'-8"

TYPICAL SECTION
Scale: 1"=1'-0"

Pay length of bridge railing to be calculated from face to face of end posts without deducting for space occupied by Electrolier.

⅛" hole in
⅜"x2½"x3¼" Pl.
2"x4"x2'-6½" L. Weld to post with continuous ⅜" fillet welds.
⅜"x3"x3¼" Pl. Weld inside rail with 3-½"x⅜" fillet weld.
Steel Tubing Post

SECTION E-E
Scale: 3"=1'-0"

⅜"x3"x3¼" Pl. Weld inside rail with 3-½"x⅜" fillet weld.
⅜" Steel Tubing Rail

SECTION F-F
Scale 3"=1'-0"

3½"x3½"x¼" Steel Tube welded to post with 4-1"x¼" fillet welds.

SECTION C-C
Scale: 3"=1'-0"

4"x4"x3/16" Steel Tube Rail
⅜"
Weld cap to post with 3/16" fillet weld. Grind exposed corners to same radius as rail

Ends of balusters welded with 4"x½"x½" fillet welded into 2"x9/16" I.P.

1½"x1½"16 Ga. Steel Tubing Balusters

Cut out bottom of tube 2¾" wide

Punch 1 1/16" holes in channel to receive balusters.

4½"x½" fillet weld

Weld 2"x½" to rail with 1"x¼" fillet welds @ 6" c/s, alternate sides of 1

Cut out bottom of tube 2¾" wide

Top of Concrete

Refer to Sheet #33 for details

SECTION A-A
Scale: 3"=1'-0"

SECTION AT EXPANSION JOINT OF RAIL
Scale: 3"=1'-0"

2½"x3½" Steel Tube welded to post with 4-1"x¼" fillet welds

NOTE:
Railing to be galvanized after fabrication.
Railing posts and balusters to be set vertical.
All welds to be shop welds.
Tubing may be manufactured in halves, welded continuously at seams, and finished flush with surface. When fabricated in this manner, the seams in the posts shall be placed in faces normal to the railing; seams in top and bottom rails shall be in side faces.
Railing panels shall be straight and true to dimension. The ends of adjacent panels shall be set parallel to each other and to the end of the bridge. Expansion joints shall be provided at the ends of the bridge and at such other points as may be necessary to accommodate the movement of the bridge. Expansion joints shall be made by leaving a space of one-half inch between the ends of the rails and inserting a piece of ½" thick felt between the ends of the posts. One complete panel shall be erected before the railing is placed in the presence of the Engineer.

AS BUILT PLANS
Corrected to
Date Approved
Resident Engr.

PWA 2013-F
Unit 2

DIST.	COUNTY	ROUTE	SECTION	SHEET NO.	TOTAL SHEETS
1/1	S.F.	56	S.F.	27	32

December 21, 1938

Approved for Commanding General
5th Corps Area

Colonel, Corps of Engineers
Engineer

4 Dia. backing for all bars except those in bottom of girders which shall be 2 dia.

Overall

Fill in between forms to make key.

SECTION (A)-(A)

1" Chamfer

3" Ruby Reflector

6"x6" 5'-0" S4S Redwood Post

Roadway Grade

1938

DATE

Scale: 3"=1'-0"

AS BUILT
Contract Completed
Date Completed

HOOKED BAR DATA

4 DIA. BACKING		ALL HOOKS		2 DIA. BACKING		
SIZE OF BAR	MINIMUM A	B	D	MINIMUM A	SIZE OF BAR
½"	1'-7½"	1¼"	2"	3¼"	½"
⅝"	1'-11½"	1⅝"	2½"	3¾"	⅝"
¾"	2'-3½"	1⅞"	3"	4¼"	¾"
⅞"	2'-7½"	2¼"	3½"	4¾"	⅞"
1"	2'-11½"	2½"	4"	5¼"	1"
1⅛"	3'-3½"	2⅞"	4½"	5¾"	1⅛"
1¼"	3'-7½"	3⅛"	5"	6¼"	1¼"

⊕ Amount to be added to overall dimension of concrete member to give the length of the hooked reinforcing bars hooked at each end.

Where girder stems and slabs are poured separately, raised keys shall be used. The 1'-6" dimension is to be approximated as closely as stirrups will permit. After concrete in stem is poured, key forms of 2"x4" lumber cut to fit shall be placed immediately and keys poured. Concrete surfaces shall all be thoroughly cleaned by wire brush & air and water pressure jets. This shall be done as soon as the concrete has hardened sufficiently to allow removal of the surface slickings and to expose clean aggregate.

KEYS - SLAB TO GIRDER

Clearance Markers to be set on right hand side of roadway as structure is approached with clearances as shown on Sheet No. 1

STANDARD 3 LIGHT CLEARANCE MARKER

6 Required
Scale: 1"=1'-0"

AS BUILT
Contract No.
Date Completed
Contractor

Sta. 45+95 — See Note — Sta. 47+87 — Sta. 49+25 — See Note — Sta. 51+17

Inside face of end diaphragm — 8¼" Merchant Casing — Approved watertight expansion joint — 10¾" Merchant Casing — Inside face of end diaphragm — Join 8¼" Merchant Casing with 12" C.M.P. Sta. 52+28

Joint detail below — Drain — Drain — Joint detail below — 12" C.M.P. — Drop Inlet — 12" C.M.P.

8" P.M.P. 8" C.M.P. — Drop Inlet — Drop Inlet — 8" P.M.P. — 12" C.M.P. — Sta. 45+21.5 — Sta. 47+49 — ℄ Roadway & Viaduct — 5⅝" Merchant Casing — Drain — Drains — 12" C.M.P. — Drop Inlet

VIADUCT B — Sta. 52+18.5 — Sta. 56+10 — Sta. 50+98 — Sta. 58+62

Drop inlets and pipe back of this point not a part of this contract. Drainage installation under this contract begins at face of drop inlet.

Inside face of end diaphragm — Approved watertight expansion joint — See Note — Inside face of end diaphragm — Drainage installation under this contract ends at face of drop inlet. Drop inlets and pipe ahead of this point not a part of this contract.

12" C.M.P. — Drop Inlet — 12½" Merchant Casing — Drain — Sta. 54+29.5 — Joint detail below — Sta. 57+62 — Sta. 59+62 — 12" C.M.P. — Drop Inlet — ℄ Roadway & Viaduct — 5⅝" Merchant Casing — Drain — Drop Inlet

VIADUCT C

Note: All drain pipe and fittings to be galvanized after shop fabrication, no field welding allowed. All field joints are to be watertight screwed connections except where flanged connections are necessary for erection.

Contractor to furnish details of pipe lay out for approval by the Engineer before fabricating. All pipes to be in place before concrete is poured.

Distance X to be determined by Contractor to suit details but not to exceed 6'-0".

Cross Drains to have minimum slope of ⅛" in 12" = 6'-0"

DRAINAGE PIPE DIAGRAMS

Scale: none

12" C.M.P. (short section) — 12" C.M.P. Band coupler — 12" C.M.P. — ¼" steel plate cut to fit end of 12" C.M.P. with hole cut to fit outside diameter of 8¼" Merchant Casing.

VIADUCT B NORTH END

EUNSTON AVENUE VIADUCTS TO GOLDEN GATE BRIDGE
VIADUCTS A, B & C
MISCELLANEOUS DETAILS
SCALE: As Noted — FILE NO:
BRIDGE NO. 34-5.1/16 — DRWG. NO. S-2328

BRIDGE DEPARTMENT

Overall Width ... 1'-0"
Clearance ... 5.44
Panels @ ... 7'-6"
Stringers ... 5
Stringer Size ... 6"x16"
Floor Beam Size ... 6"x12"
Posts, etc. ... 6"x6"

Bent No. 1 | Bent No. 2

PLAN

¾" Bars, 1'-3" long — 6¾" — 12-3/4" @ 12-3/4" @ 12-3/4" — ℄ Curb — Const. Jt. — Roadway Surface — ⅜ Fillet welds — ¾" Bars, 1'-9" long — 5⅝" Merchant Casing — Drain

Note: Drain to be galvanized after all welding is completed.

7½" — 1'-3" — 7½" — Slope Concrete 1:1 — ⅜ Fillet welds — 5⅝" Merchant Casing

Note: Connection to merchant casing and cross drain to be detailed by pipe fabricator

SECTION (B)-(B)

DRAIN DETAIL
5/10 Required
Scale 3"=1'-0"

SECTION (A)-(C)

End diaphragm — 8¼" C.M.P. — Fillet weld all around nipple set inside end of 8" C.M.P. and welded all around — 8¼" Merchant Casing coupling — End diaphragm — 12" C.M.P. — ⅜"x5" sleeve welded all around to first crest of 12" C.M.P. and to 12¼" Merchant Casing nipple — 12¼" Merchant Casing nipple — 12¼" Merchant Casing coupling — End diaphragm — 8¼" Merching Casing — Fillet weld all around

VIADUCT B SOUTH END — VIADUCT C

JOINTS AT ENDS OF BRIDGE
Scale: none

AS BUILT PLANS
Contract No.
Date Completed
Engineer

PWA 203-F
Unit 2

FED. ROAD DIST. NO.	STATE	ROUTE NO.	FISCAL YEAR	SHEET NO.	SHEETS
12	CAL.				

DIST.	COUNTY	ROUTE	SECTION	SHEET NO.	TOTAL SHEETS
IV	S.F.	56	S.F.	28	33

December 21, 1938

Approved for Commanding General
9th Corps Area
Colonel, Corps of Engineers
Engineer

BRIDGE DEPARTMENT

PANEL SECTION E-E

PANEL SECTION L-L

SECTION F-F

TYPE "A"

SECTION M-M

TYPE "D"

PANEL SECTION G-G

SECTION H-H

TYPE "B"

Contract Change-Order No. 2
Approved, Office, Chief of Engineers
Date of approval July 3, 1940

DIVIDED ROADWAY
TYPICAL INSTALLATIONS
Scale: 1"=10'-0"

Note
Shrub Areas As Per Special Provision

FUNSTON AVENUE VIADUCTS
TO GOLDEN GATE BRIDGE
VIADUCTS
RECESSED CURB FACE

AS BUILT PLANS
Contract No.
Date Completed
Document No.

PWA 2013-F
Unit 2

Dist.	County	Route	Section	Sheet No.	Total Sheets
IV	SF	58	SF	29	53

December 21 1938

"Approved" for Commanding General
9th Corps Area
Colonel, Corps of Engineers
Engineer

BRIDGE DEPARTMENT

Sub-Station under

Cap conduits 1'-6" below grade at end of wall

2-3"Ø, 5-4" Conduits

Paving Notch

45'-40'-5

Expansion Joint Sta 45+72.00

Electrolier Sta 46+35.00

Expansion Joint Sta 47+08.00

Bridge

Expansion Joint Sta 47+22.00

Electrolier Sta 47+85.00

1½" Conduit
2" Conduit

3" Conduit

Pull Box

Expansion Joint Sta 53+00.00

Paving Notch

Expansion Joint Sta 53+27.00

Electrolier Sta 53+41.00

Cap conduits 1'-6" below grade

2-2" & 1-1½" Conduits brought back out of substation and capped 1'-6" below grade on E.W.O. No. 4844-A

Electrolier Sta 48+01.00

VIADUCT "B"
Scale 1"=30'

Electrolier Sta 51+31.00

Electrolier Sta 52+29

TO SANTA CRUZ

Paving Notch

Cap Conduits 1'-6" below grade

2" Conduit

Bridge

1½" Conduit

Electrolier Sta 35+24.00

Paving Notch

Cap conduits 1'-6" below grade

Pull Box

Bridge

1½" Conduit
2" Conduit

Cap Conduits 1'-6" below grade

VIADUCT "A"
Scale 1"=30'

Electrolier Sta 57+91.00

Expansion Joint Sta 58+61.00

Paving Notch

1½" Conduit
2" Conduit

3" Conduit

GOLDEN GATE BRIDGE

Pull Box

1½" Conduit cross-over

Cap conduits 1'-6" below grade

Cap conduits 1'-6" below grade

Pull Box

Cap conduits 1'-6" below grade

Cap conduits 1'-6" below grade

Pull Box

Cap conduits 1'-6" below grade

Pull Box

Cap conduits 1'-6" below grade

Pull Box

 

 

PWA-2013-F
Unit 2

Fed. Proj. Engr. No.	Sheet No.	Supers. Sht.	Revised Sht.	Added Sht.
2	34A			

Date	Superv.	Drawn	Traced	Checked
7/1	S.A.	E.S.	G.F.	J.J.

December 21, 1938

Approved for Commanding General
9th Corps Area

Colonel, Corps of Engineers
Engineer

BRIDGE DEPARTMENT

To Tunnel through Retaining Wall Encased in Conc. 1 Junc. Box

1½" Conduit to Sub. north

3" Service

¾" Overhead

2'-6"

2'-6"

PLAN

EAST WALL

WEST WALL

Contract Sketch No. 3
Fed. Proj. 2013-F Unit 2
Contr. Complete July 5, 1938

Note: Transformers, switches, and wiring are not a part of this Contract.
For Sub Station dimensions refer to sheets 31 and 32.
All conduits not shown on this plan shall be located as directed by the Engineer.

THIS SHEET SUPERSEDED BY SHEET NO. 34-A

SOUTH WALL

NORTH WALL

AS BUILT PLANS
Contract No.
Date Completed
Document No.

FUNSTON AVENUE OVERPASS
OF DEPARTMENT OF PUBLIC WORKS
OF THE CITY AND COUNTY OF SAN FRANCISCO
SUBSTATION CONDUIT DETAILS

Sheet No. 32A of 3

CONDUIT ENCASEMENT DETAIL

This cond. to be turned out to electroliers.

Cinch anchors & clamps

Cond. Sizes

Conduits to be placed 6" apart.
Conduits shall have 4" min. cover Class B. Concrete.
Conduits shall be installed on West side of highway back of curb.
Viaduct A, B & C Contractor to place above conduit between Substation & Sta. 43+75 ~~& place a 12"-3C-10 Conc. Pull Box with 2-2"x2" angle iron frames, 5-6"x4"-35# separators & steel cover. Galvanize all iron & steel. (Sta. 43+75)~~

2-2" & 1-1¼" Conduits installed on ENG. #844-A. See Sheet No. 29

Place 3"x2½" & 2"x1½"x12'-0" angles 6' from wall. Weld 3-12" pieces to each angle & anchor in with Galvanized steel.

2-7" & 1-1¼" Conduit crossings (Cap 8' inside Substa.)

3" Cond.

2-3"&5-1" Conduits from Tunnel Stub, cut 2" & Cap.

3" Conc. cover around conduit

3"/2" & 1¼" Conduits from North

1¼" Cond. to Tunnel. See Detail for Arrangement

1¼" Conduit to Sta. north

2-3"&5-1" Cond.

Vault

2-2" Conduits

2-2" Conduits

PLAN

CT

LINE

IV-SF-SB-SF.
PROPOSED FUNSTON AVE. APPROACH
SUBSTATION DETAILS
Scale, ⅜"=1'-0" December 1938
Revised June 1939

AS BUILT PLANS
Contract No.
Date Completed
Voucher No.