Dist	COUNTY	ROUTE	POST MILES TOTAL PROJECT	SHEET No.	TOTAL SHEETS
10	SJ	5,26, 88,132	Var	1	21

STATE OF CALIFORNIA
DEPARTMENT OF TRANSPORTATION

PROJECT PLANS FOR CONSTRUCTION ON
STATE HIGHWAY

IN SAN JOAQUIN COUNTY
AT VARIOUS LOCATIONS

TO BE SUPPLEMENTED BY STANDARD PLANS DATED 2010

INDEX OF PLANS

SHEET NO.	DESCRIPTION
1	TITLE AND LOCATION MAP
2-3	CONSTRUCTION AREA SIGNS
4	TRAFFIC HANDLING PLAN
5-6	SUMMARY OF QUANTITIES
7-12	REVISED STANDARD PLANS
STRUCTURE PLANS	
13-21	VARIOUS BRIDGES

THE STANDARD PLANS LIST APPLICABLE TO THIS CONTRACT IS INCLUDED IN THE NOTICE TO BIDDERS AND SPECIAL PROVISIONS BOOK.

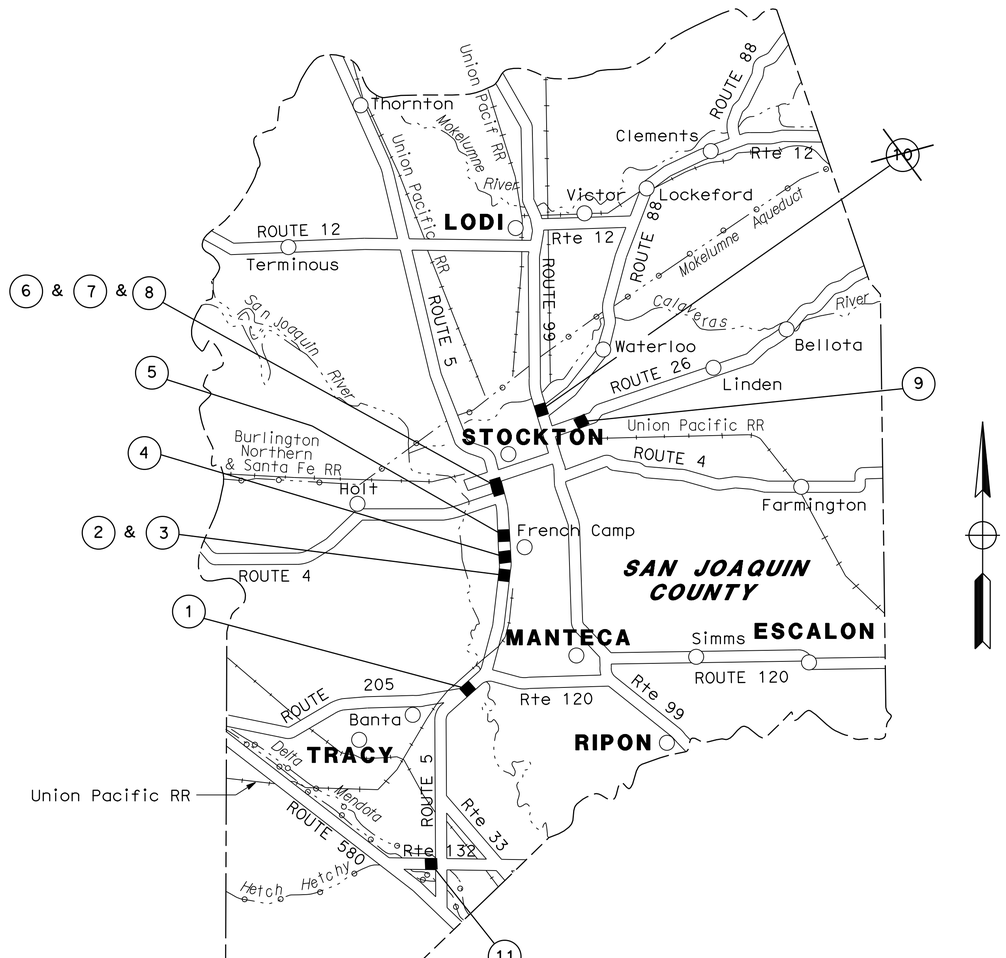

LOCATION MAP

LOCATIONS OF CONSTRUCTION

Loc No.	ROUTE	PM	STRUCTURE NAME	BRIDGE No.
1	5	R13.87	PARADISE CUT OVERFLOW	29-0029R
2		R19.58	ROTH ROAD UC	29-0216L
3		R19.58	ROTH ROAD UC	29-0216R
4		R21.44	MATHEWS ROAD UC	29-0218L
5		R23.93	WALKER SLOUGH	29-0223R
6		25.78	TAYLOR STREET OH	29-0230L
7		25.87	ROUTE 5-4 CONNECTOR VIADUCT	29-0233H
8		26.12	ROUTE 5/4 Sep	29-0232L
9	26	1.9	STOCKTON DIVERTING CANAL	29-0040
~~10~~	~~88~~	~~0.01~~	~~ROUTE 88/99 Sep~~	~~29-0143~~
11	132	3.22	DELTA MENDOTA CANAL (132E-5S)	29-0313G

1

1 REVISED PER ADDDENDUM No. 1 DATED APRIL 23, 2014

THE CONTRACTOR SHALL POSSESS THE CLASS (OR CLASSES) OF LICENSE AS SPECIFIED IN THE "NOTICE TO BIDDERS."

NO SCALE

Rhodel DeClaro 12/19/13
PROJECT ENGINEER DATE
REGISTERED CIVIL ENGINEER

January 27, 2014
PLANS APPROVAL DATE

REGISTERED PROFESSIONAL ENGINEER
RHODEL De CLARO
No. 74058
Exp. 6/30/15
CIVIL
STATE OF CALIFORNIA

THE STATE OF CALIFORNIA OR ITS OFFICERS OR AGENTS SHALL NOT BE RESPONSIBLE FOR THE ACCURACY OR COMPLETENESS OF SCANNED COPIES OF THIS PLAN SHEET.

CONTRACT No.	**10-0X7804**
PROJECT ID	**1013000025**

PROJECT MANAGER ALVIN MANGINDIN
DESIGN ENGINEER ALVIN MANGINDIN

LAST REVISION 00-00-00
DATE PLOTTED => 23-APR-2014
TIME PLOTTED => 10:54